


Desert Vista Commerce Center

7810 South Hardy Drive . Tempe

Suite 109 - 4,093 RSF

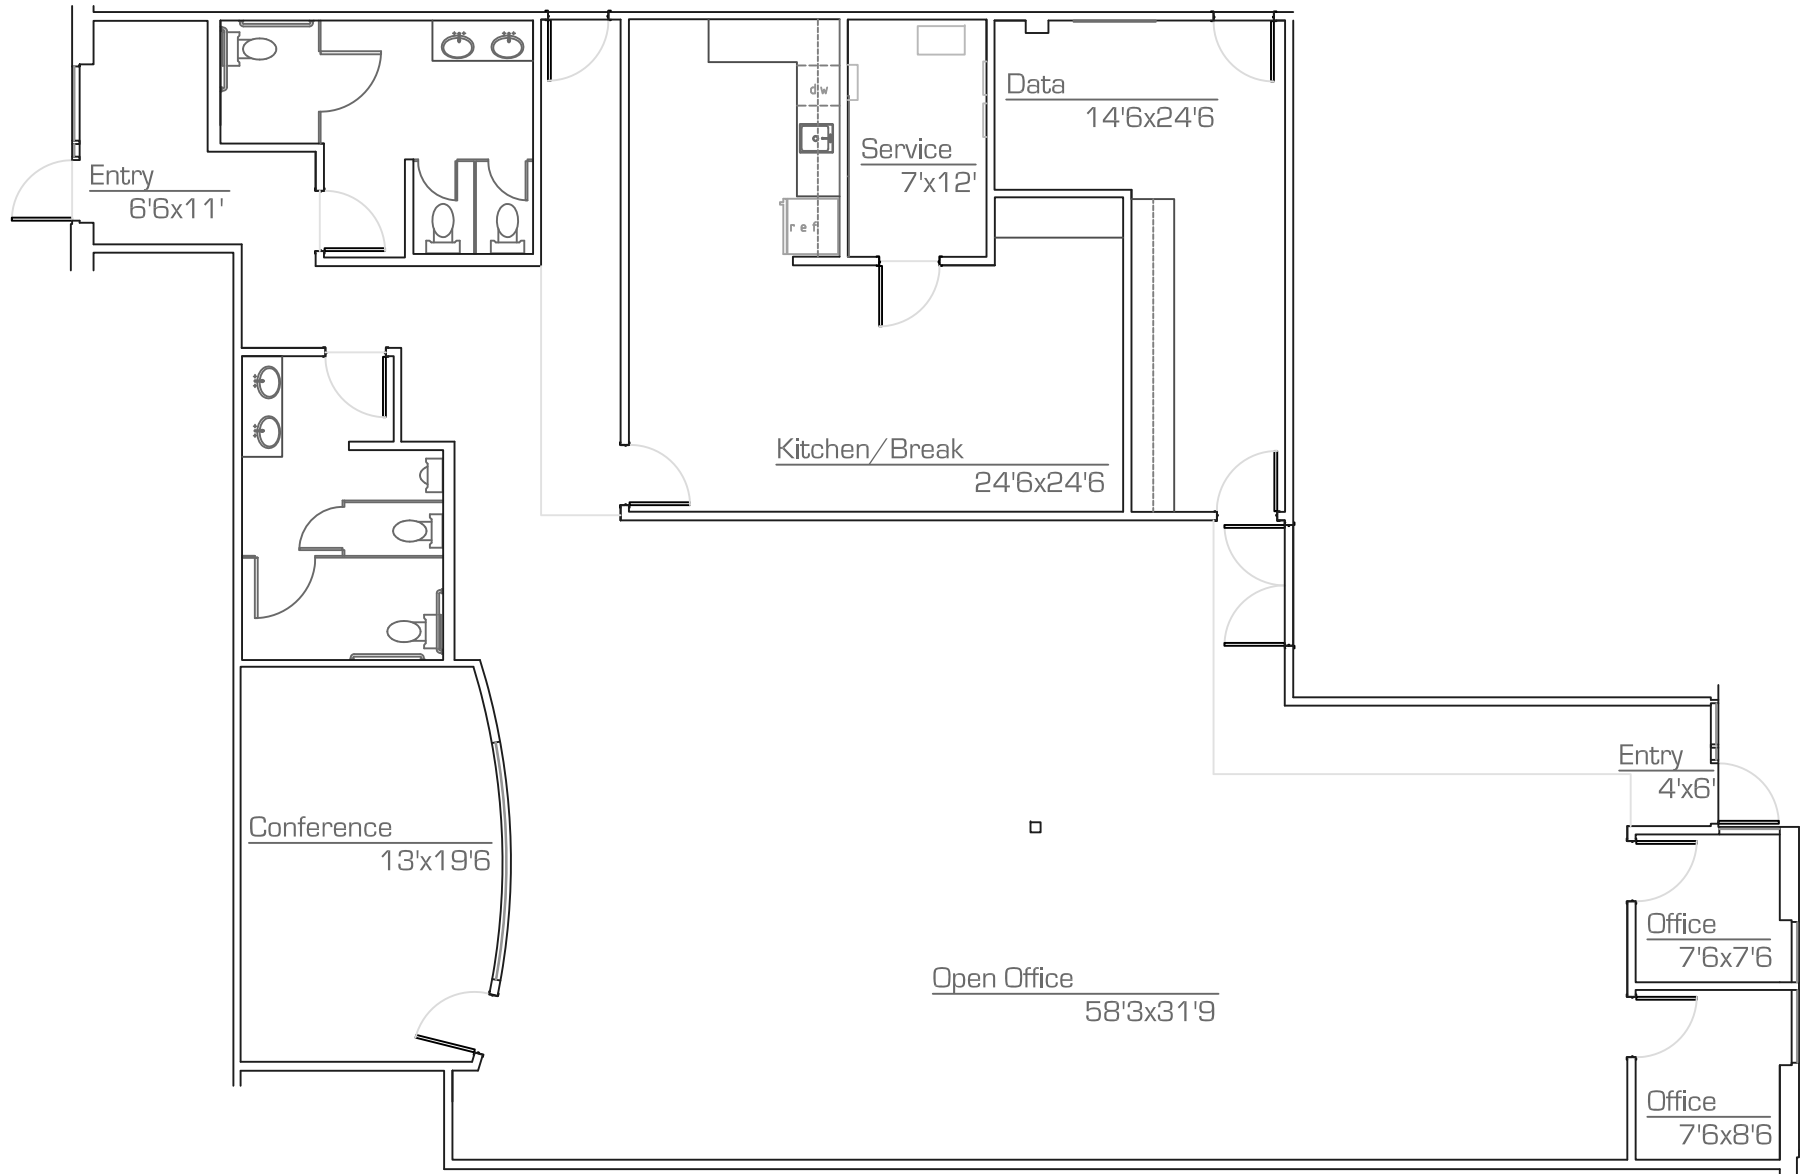


as-built

scale: nts

30.December.2010

*All dimensions are approximate and all information is of general nature.

precision**DIMENSIONS**

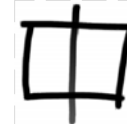

as-built . space plans
architectural design

602.790.6412