


# Green Gables

2345 East Thomas Road . Phoenix

**Suite 464 - 757 RSF**

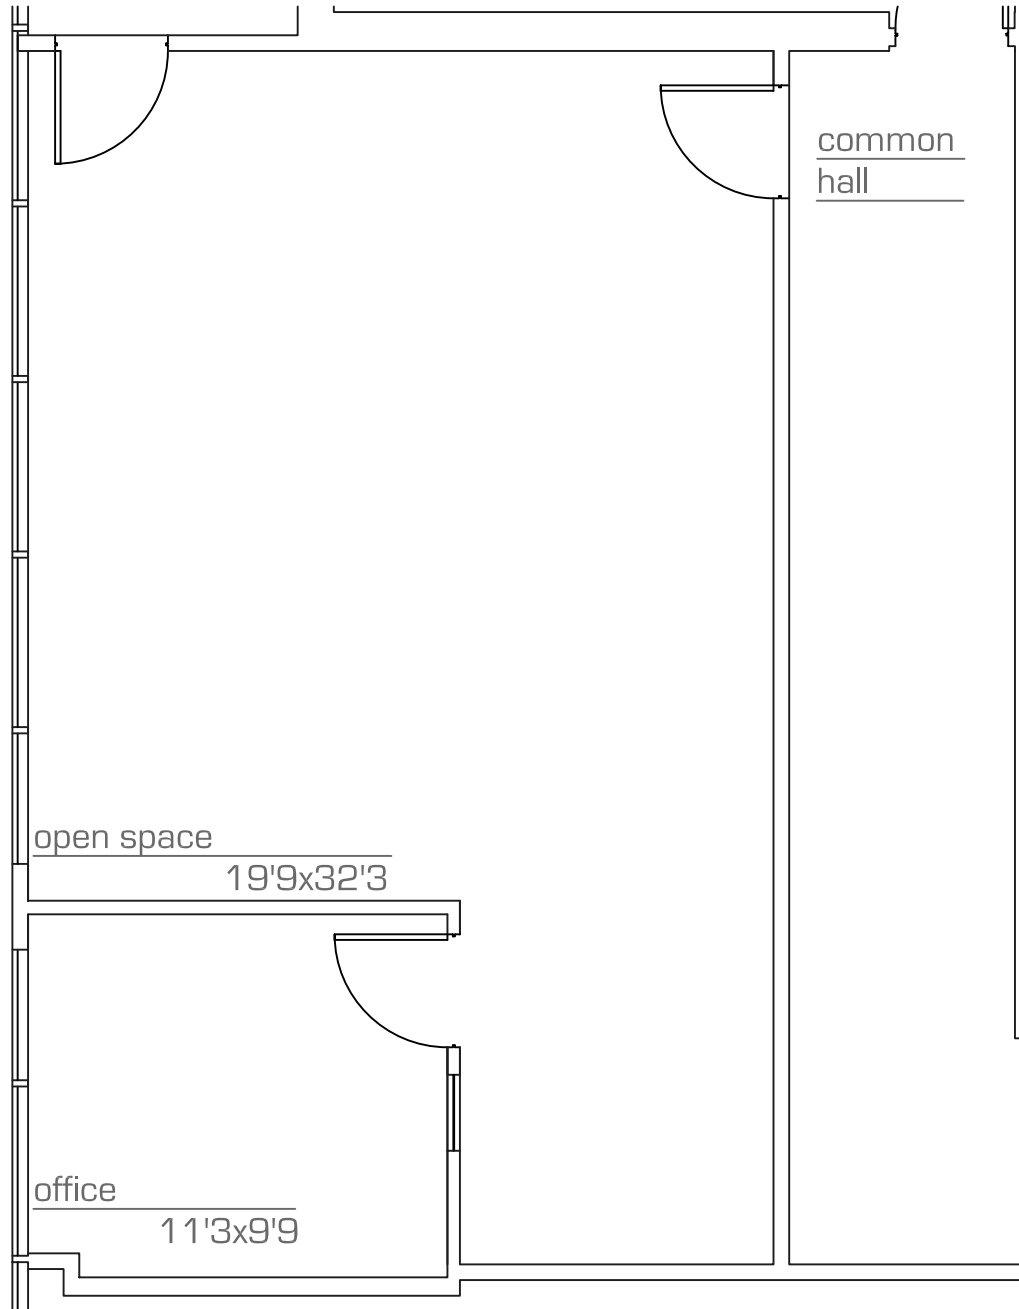

**as-built**

scale: nts

3.October.2007

\*All dimensions are approximate and all information is of general nature.

precision**MEASUREMENTS**



as-built . space plans  
architectural design

602.790.6412