
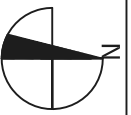


Airport Business Center

437 South 48th Street - Tempe

Suite 101 - 1,728 RSF

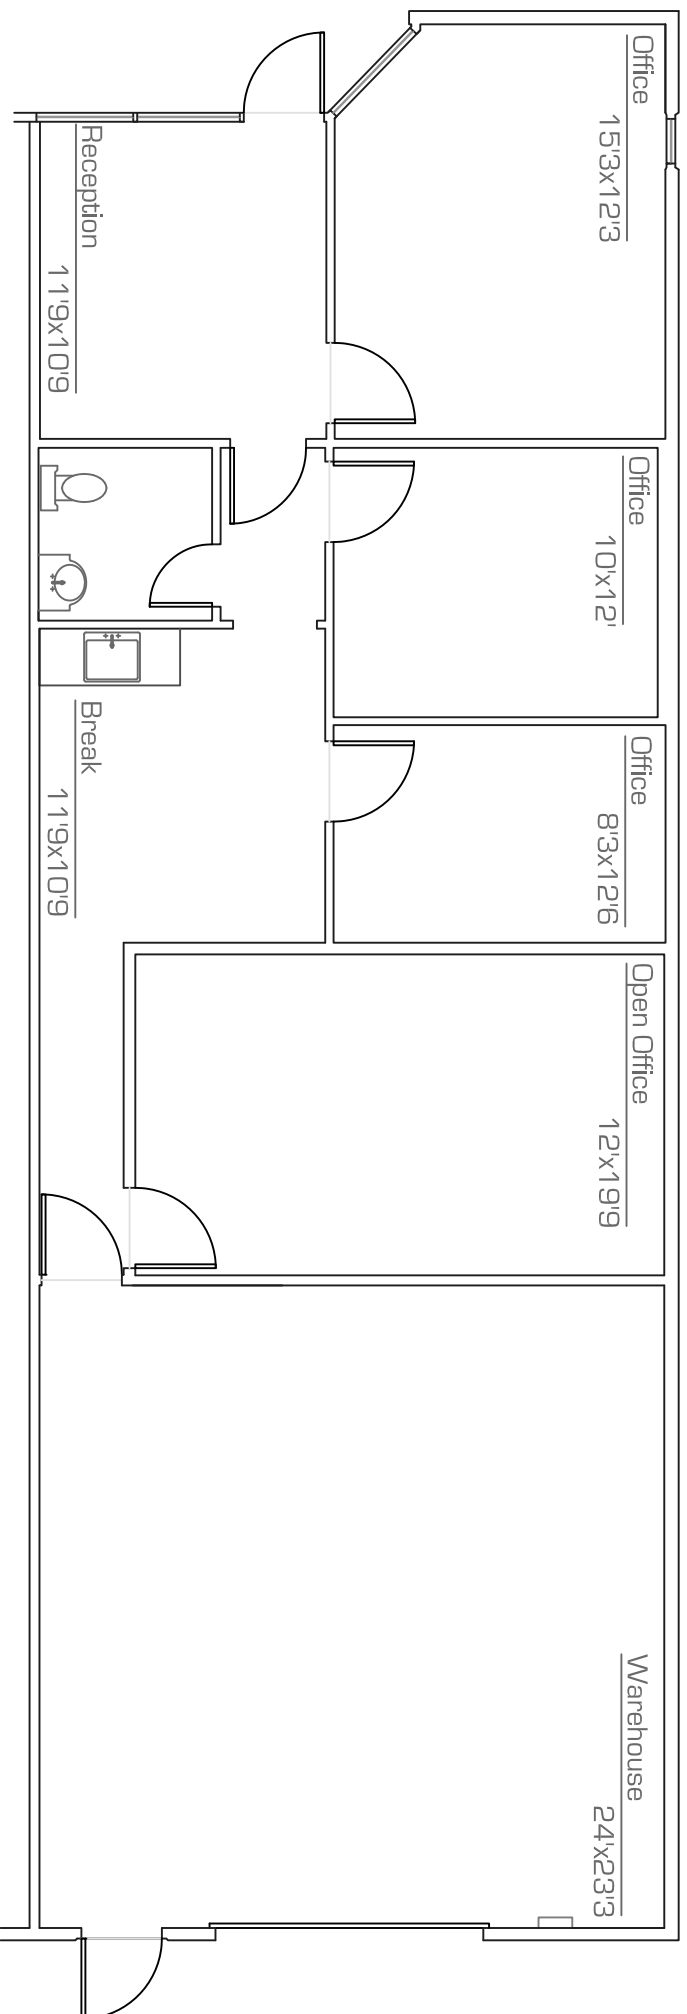

as-built

scale: nts

22.July.2009

* All dimensions are approximate

* All information is of general nature

precision **DIMENSIONS**



as built . space plans
architectural design

602.790.6412