


Airport Business Center

437 South 48th Street . Tempe
Suite 106 - 1,008 RSF

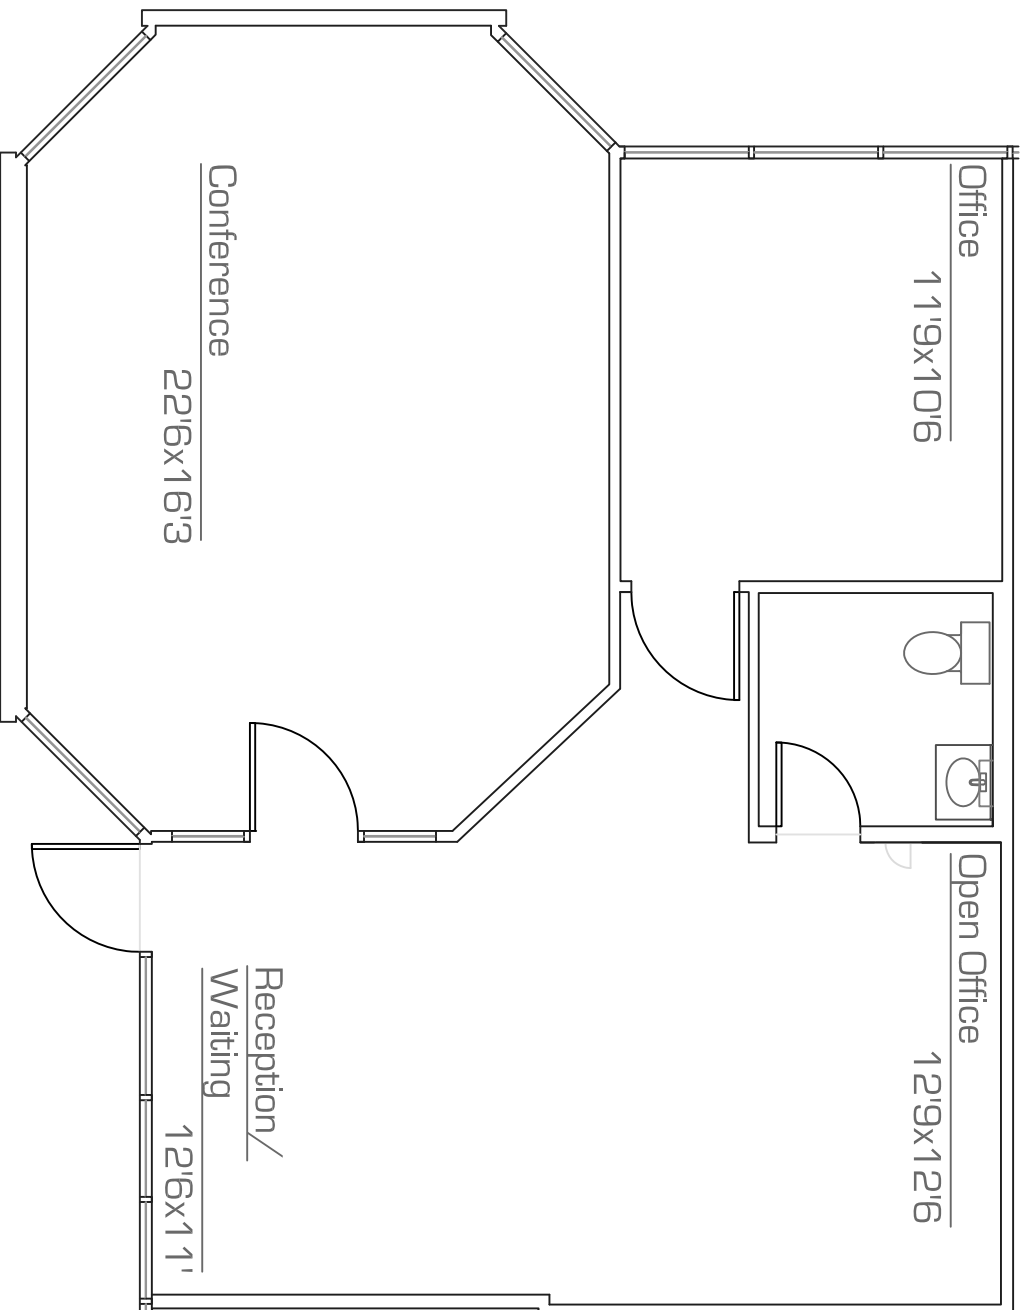

as-built

scale: nts

September.2011



* All dimensions are approximate at ± 3"
* All information is of general nature

precision **DIMENSIONS**
as built . space plans
architectural design
602.790.6412

