


Airport Business Center

437 South 48th Street . Tempe
Suite 107 - 1,008 RSF

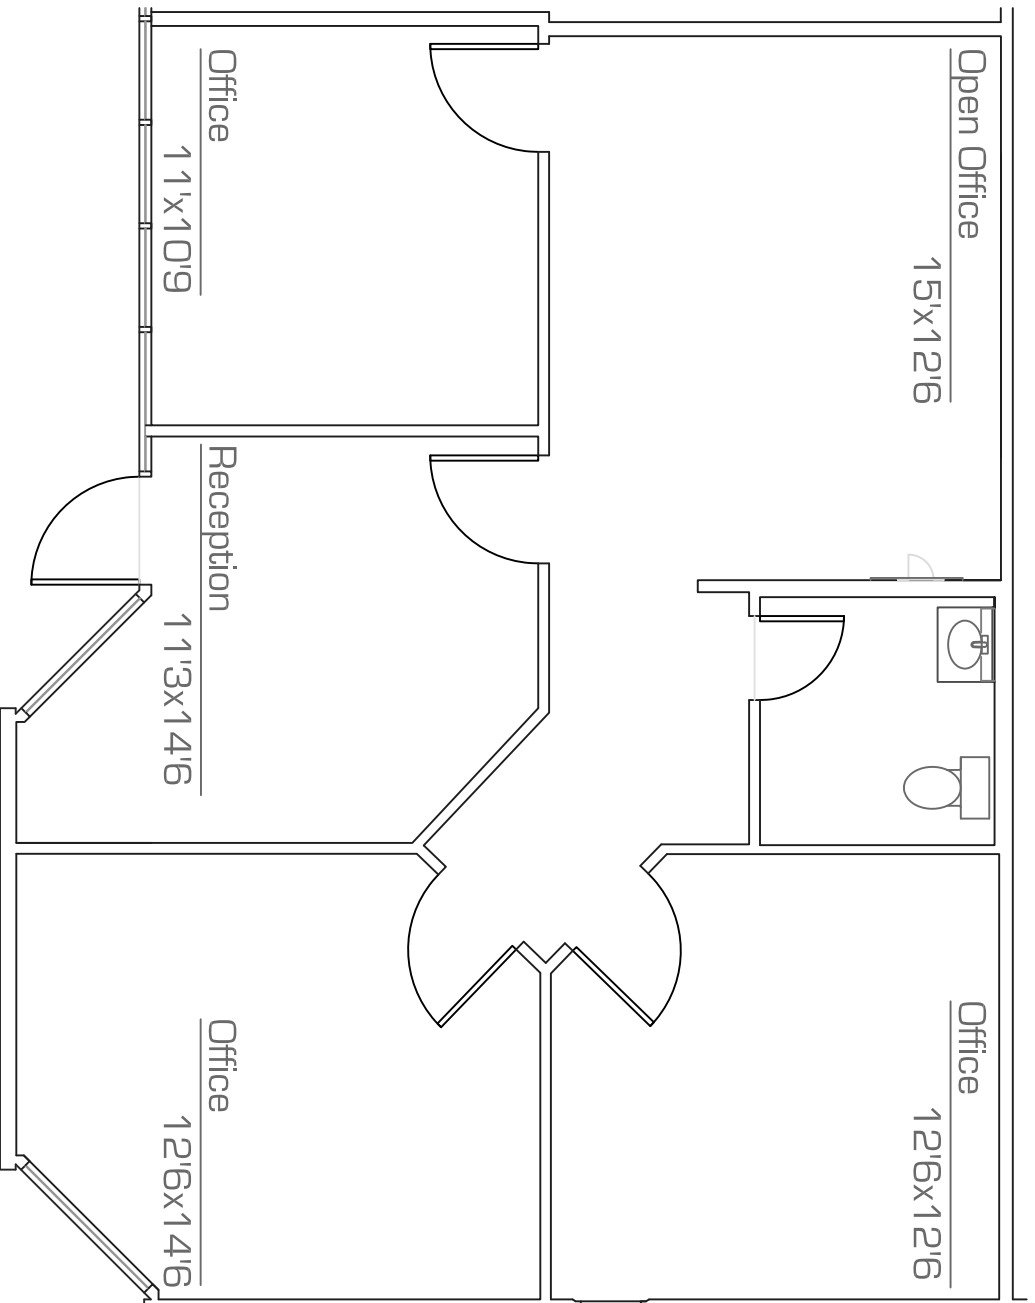

as-built

scale: nts

11.May.2010



*All dimensions are approximate and all information is of general nature.

precision **DIMENSIONS**

as built . space plans
architectural design



602.790.6412