


Airport Business Center

501 South 48th Street . Tempe

Suite 105/106 - 2,880 RSF

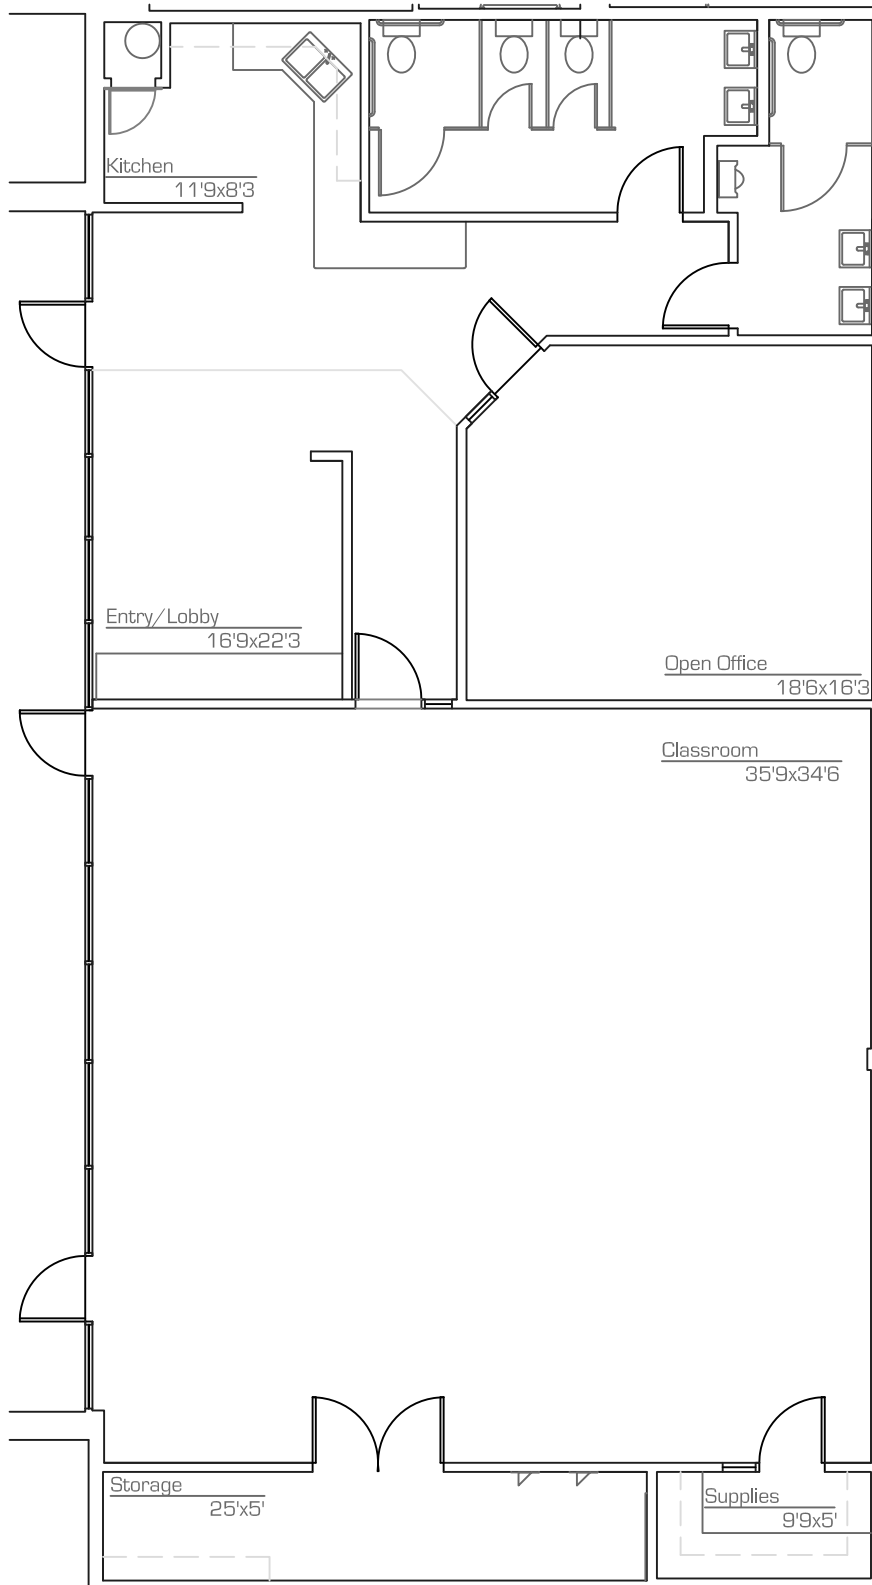

as-built

scale: nts

January.2010

*All dimensions are approximate and all information is of general nature.

precision**DIMENSIONS**



as built . space plans
architectural design

602.790.6412