


Airport Business Center

501 South 48th Street . Tempe


Suite 110 - 2,400 RSF

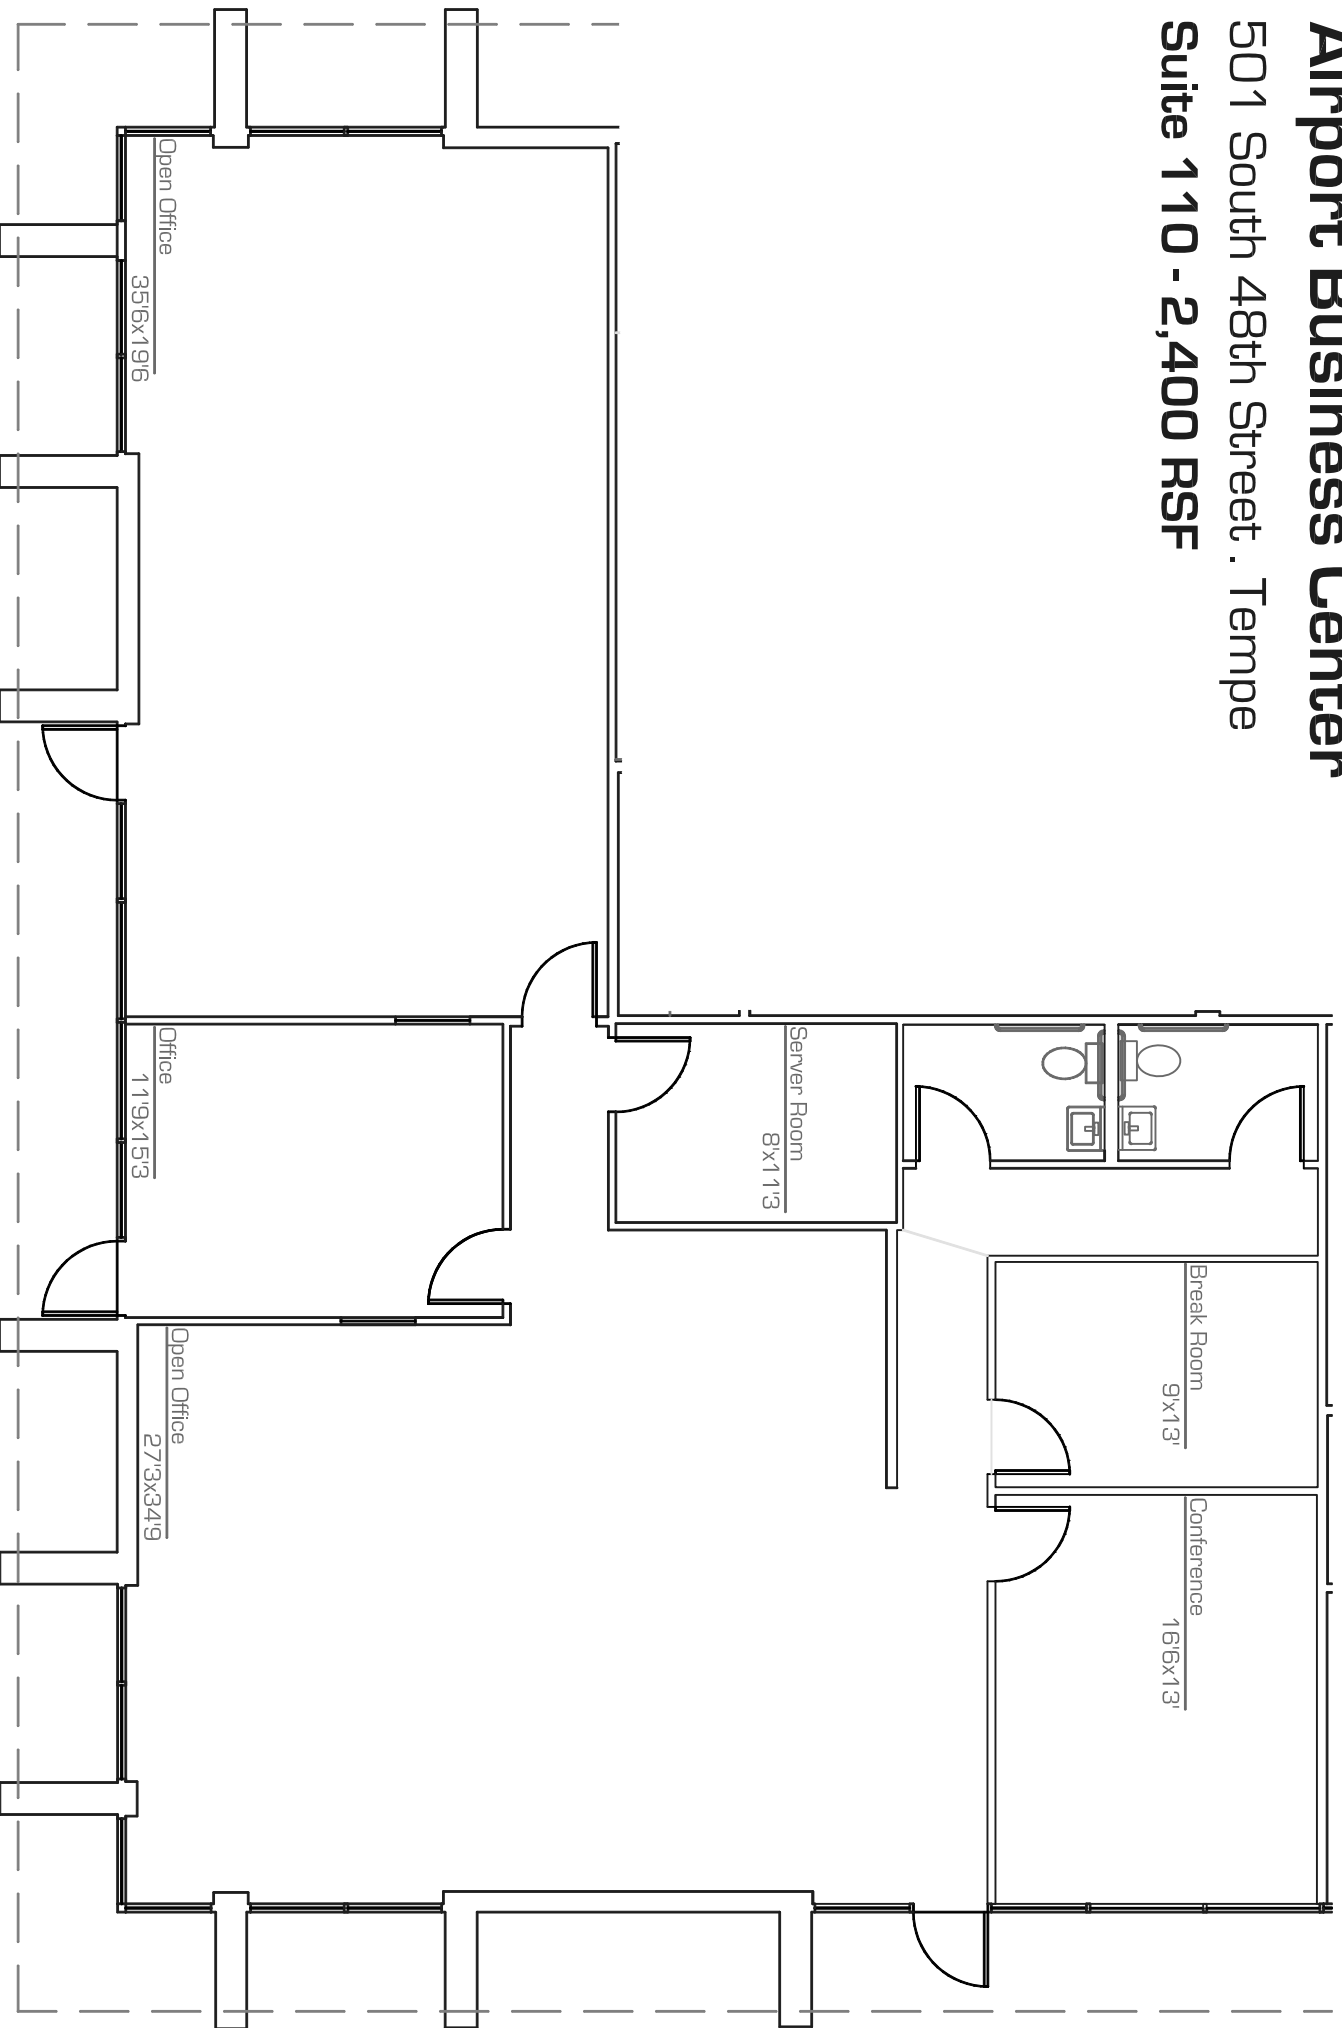

as-built

scale: nts

January, 2008

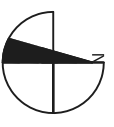

* All dimensions are approximate and all information is of general nature.

precision **DIMENSIONS**

as built . space plans
architectural design



602.790.6412