


Airport Business Center

509 South 48th Street . Tempe

Suite 103 - 862 RSF

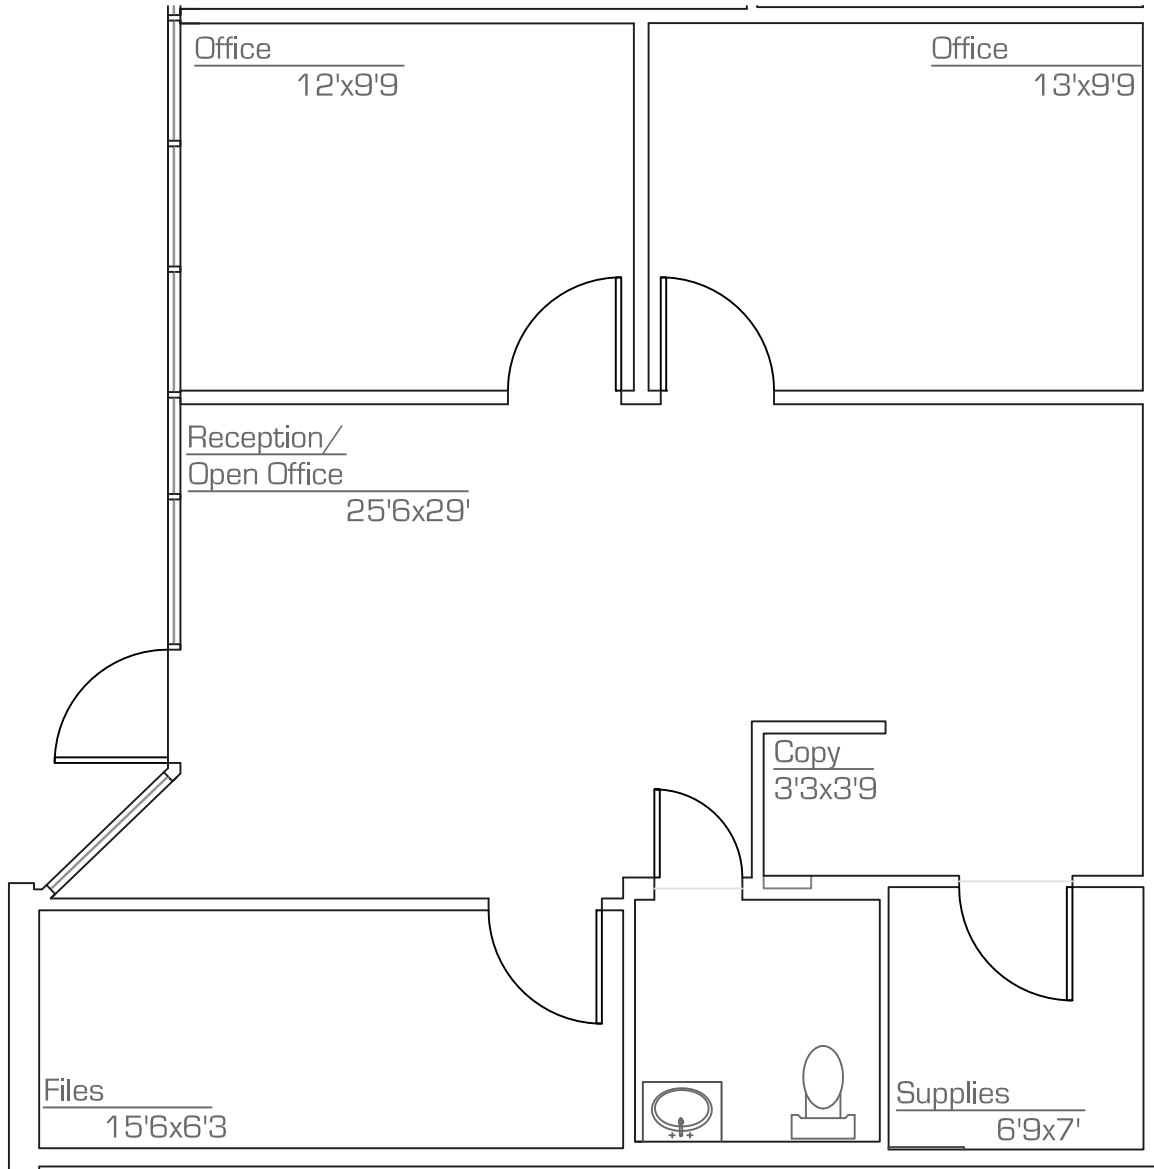

as-built

scale: nts
3.May.2011

*All dimensions are approximate at $\pm 3"$
*All information is of general nature

precision**DIMENSIONS**



as built . space plans
architectural design

602.790.6412