


Airport Business Park


509 South 48th Street - Tempe
Suite 105-106 - 2,400 RSF

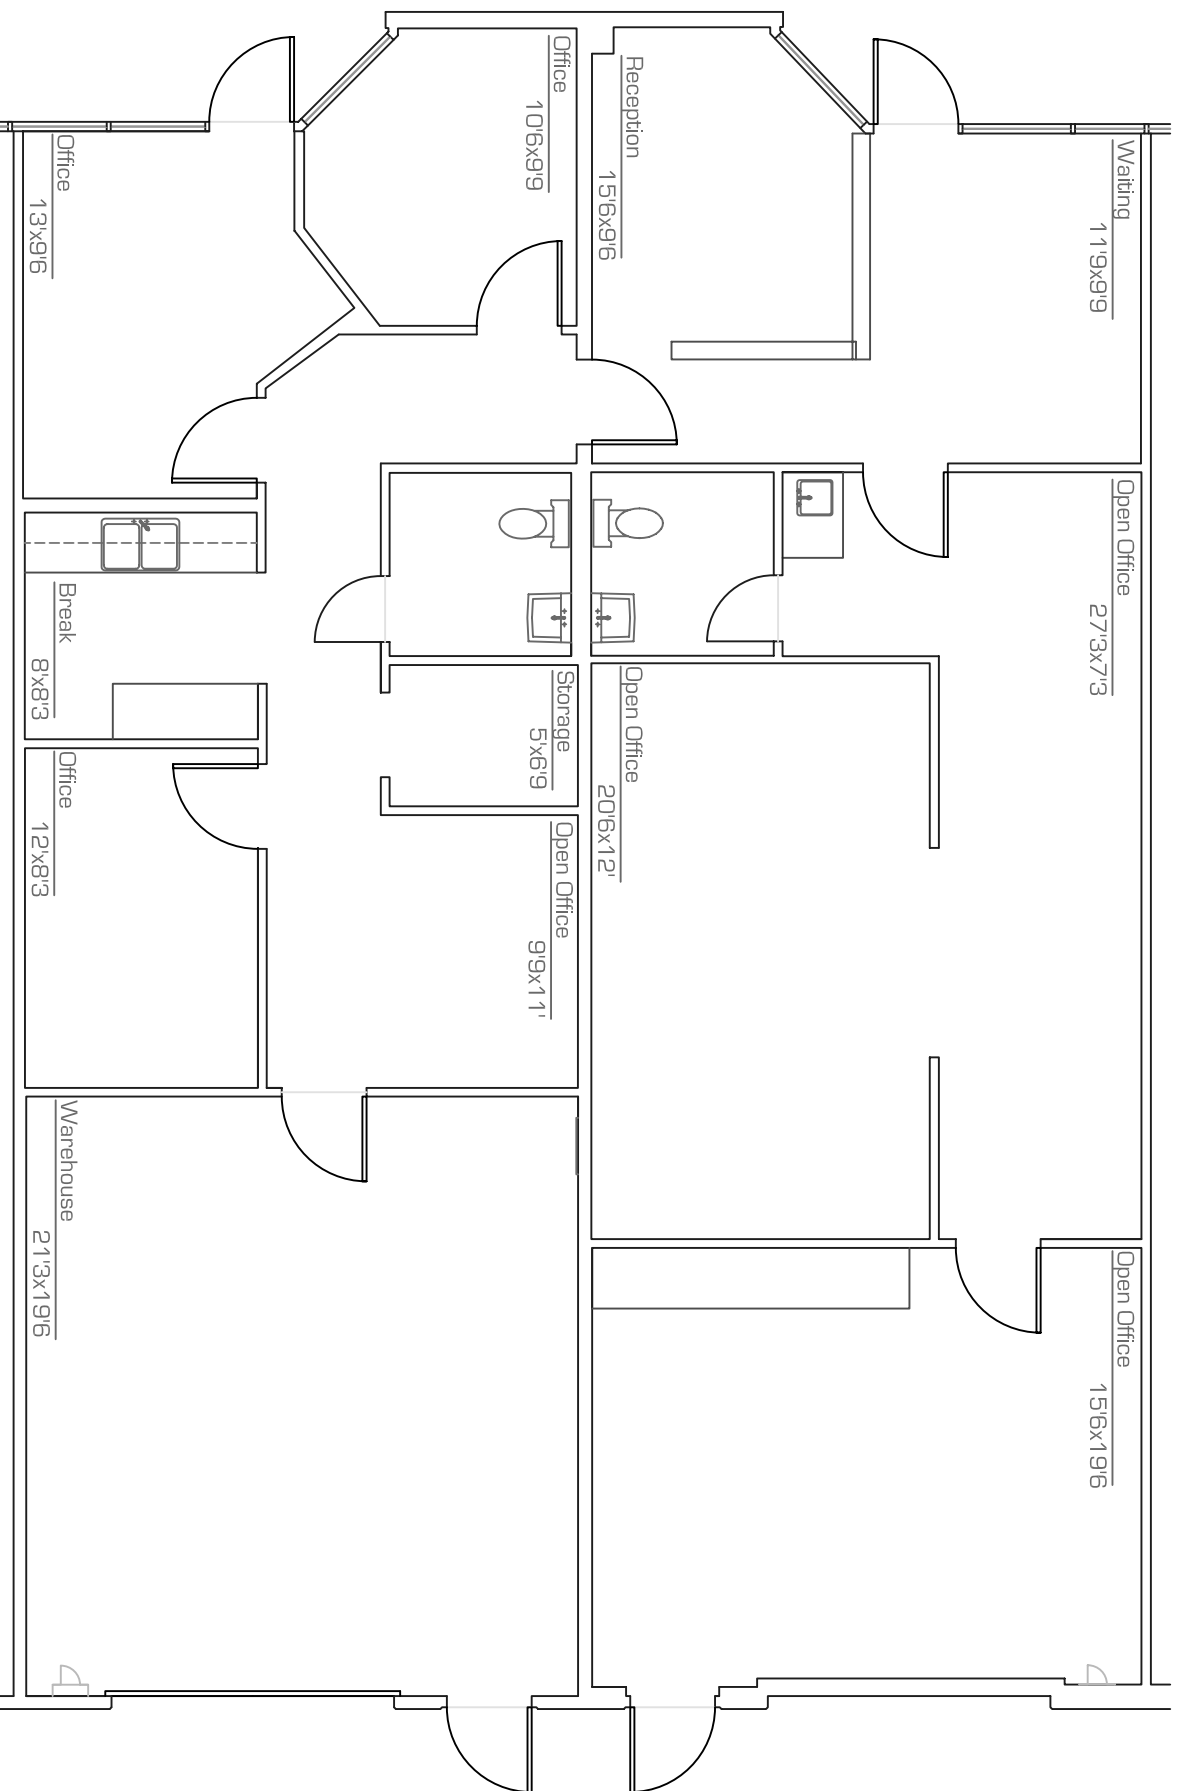

as-built

scale: nts
10.August.2008

* All dimensions are approximate
* All information is of general nature

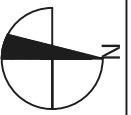

precision MEASUREMENTS



as built . space plans
architectural design
602.790.6412