


# Airport Business Center

509 South 48th Street . Tempe

Suite 107 - 1,200 RSF

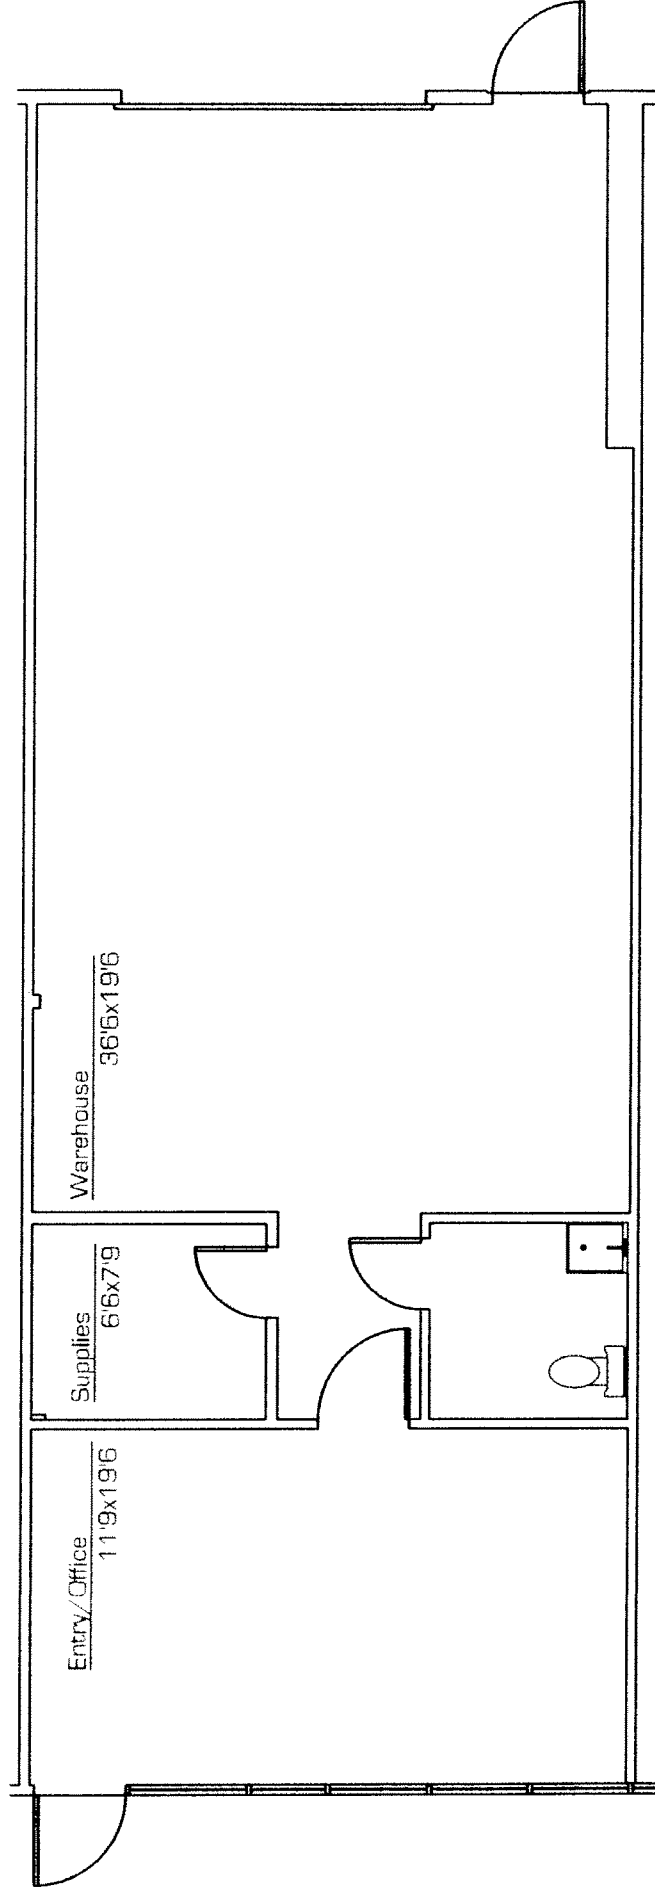

**as-built**

scale: nts

19.February.2008

\*All dimensions are approximate and all information is of general nature.

precision **MEASUREMENTS**



as built . space plans  
architectural design  
602.790.6412