


# Airport Business Center

515 South 48th Street - Tempe

Suite 102 - 1,800 RSF

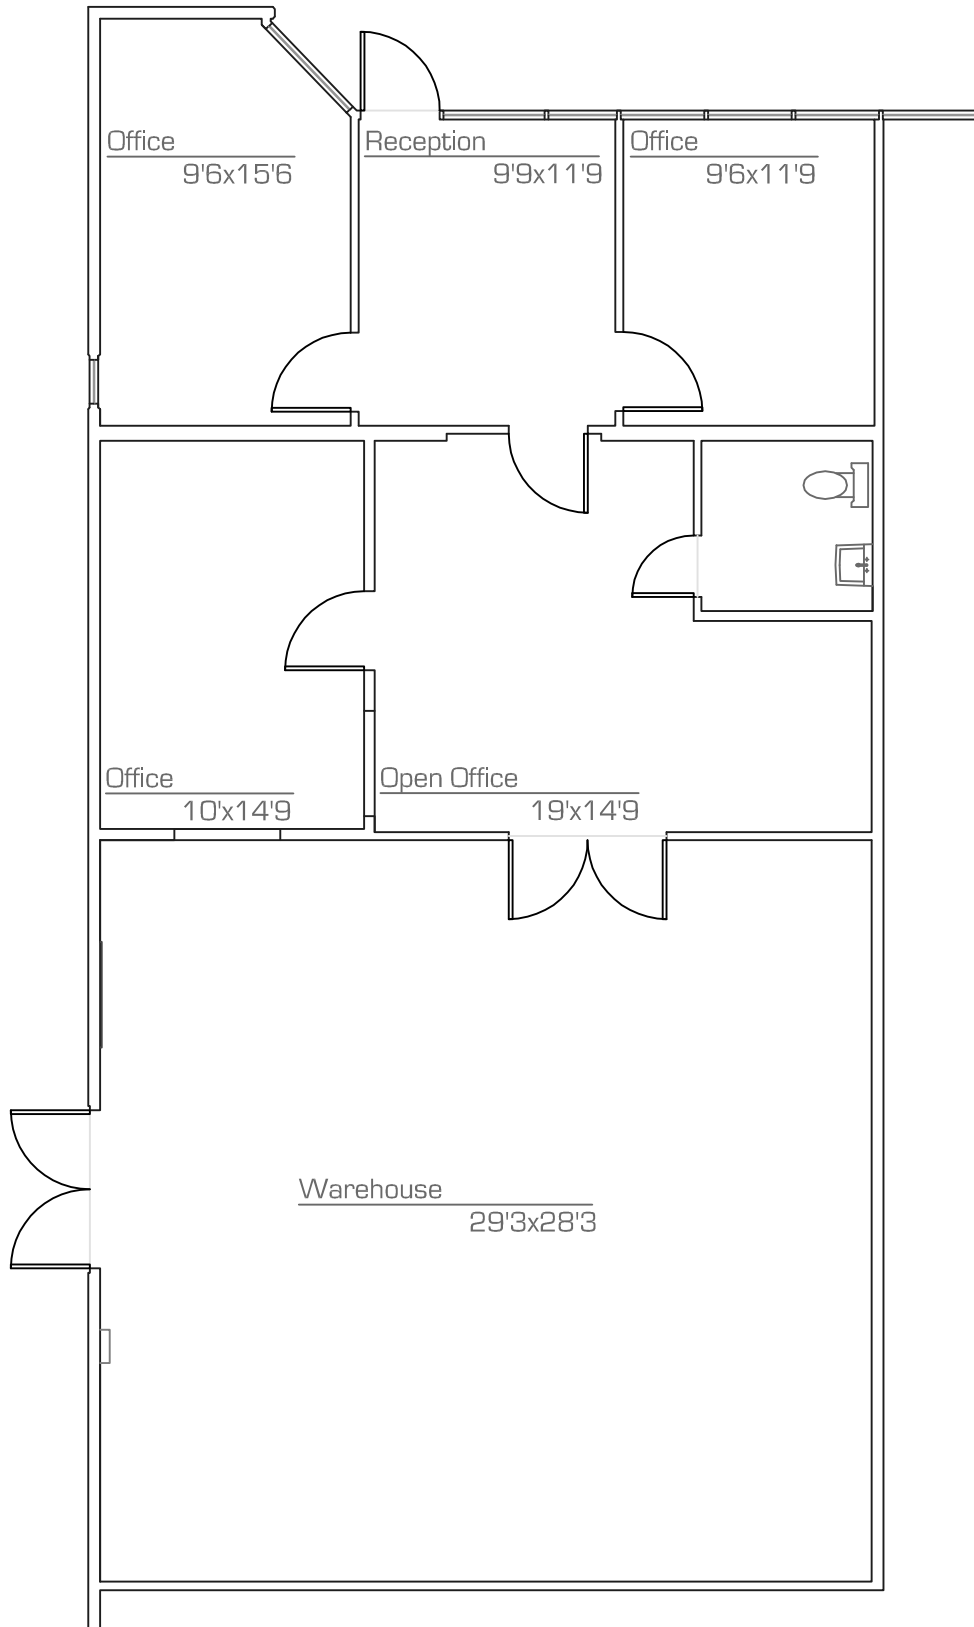

**as-built**

scale: nts  
3.June.2009

\*All dimensions are approximate  
\*All information is of general nature

precision**DIMENSIONS**



as built . space plans  
architectural design

602.790.6412