


# Airport Business Center

515 South 48th Street . Tempe  
**Suite 106 - 1,200 SF**

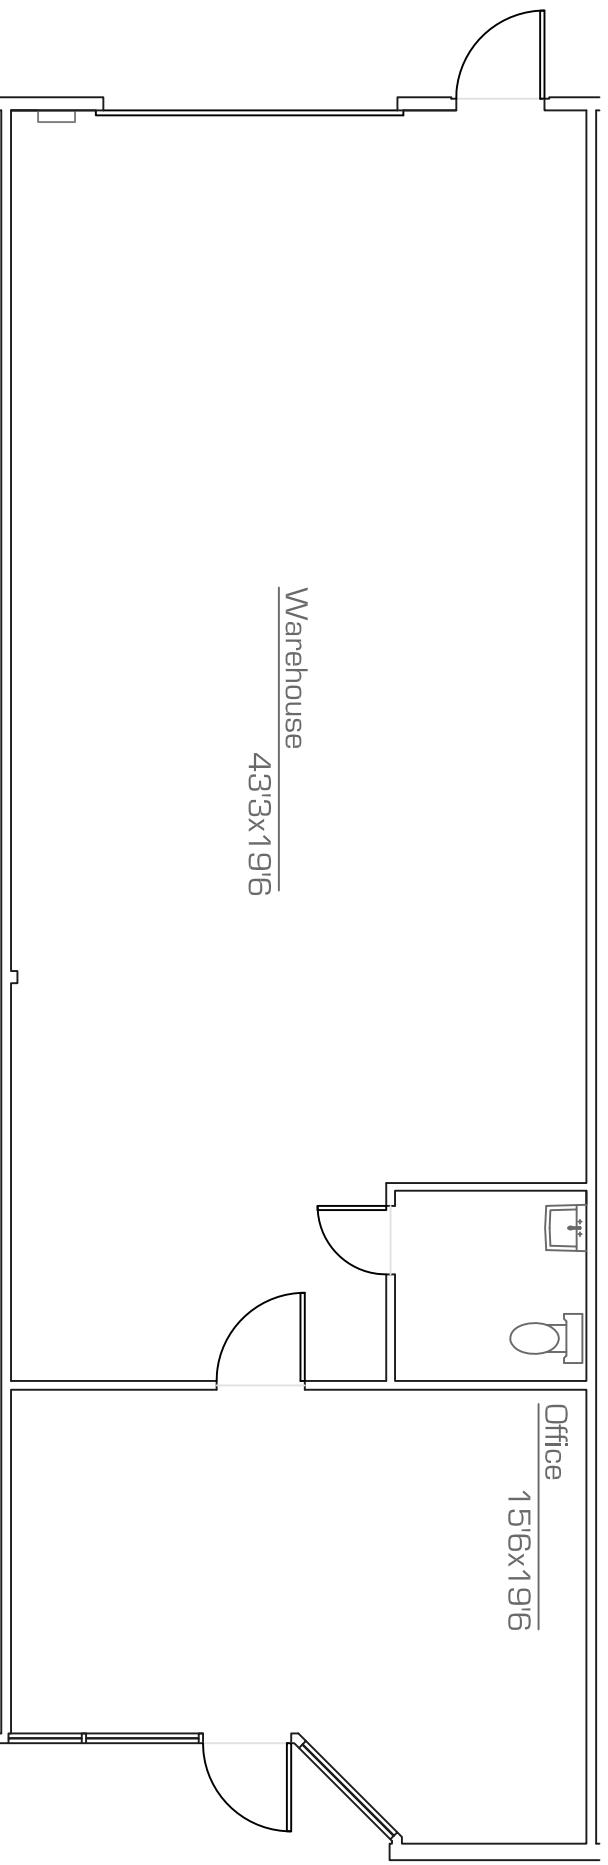

**as-built**

scale: nts

11.May.2010

\* All dimensions are approximate

\* All information is of general nature

precision **DIMENSIONS**



as built . space plans  
architectural design

602.790.6412