


Airport Business Center

521 South 48th Street - Tempe
Suite 106/107 - 3,072 RSF

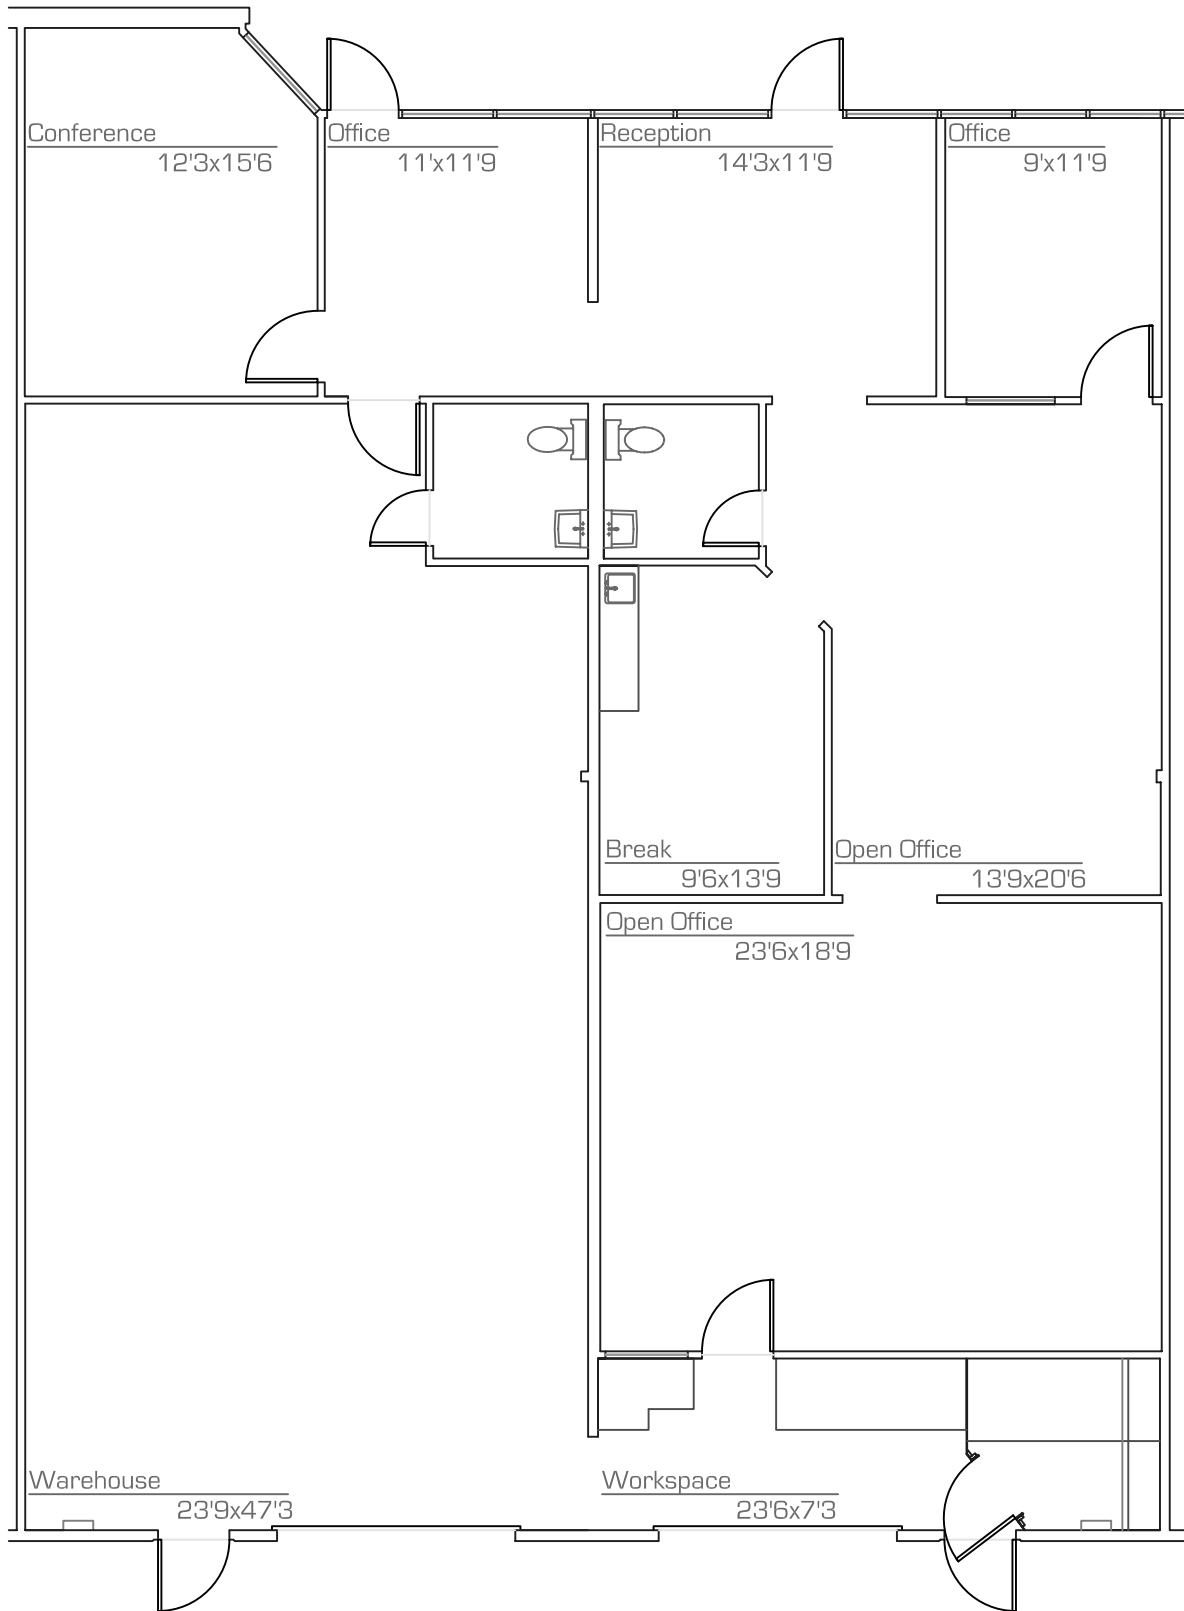


as-built

scale: nts
20.October.2008

*All dimensions are approximate
*All information is of general nature

precision**MEASUREMENTS**

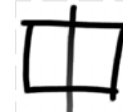

as built . space plans
architectural design

602.790.6412