


Airport Business Center

521 South 48th Street . Tempe

Suite 108 - 1,536 RSF

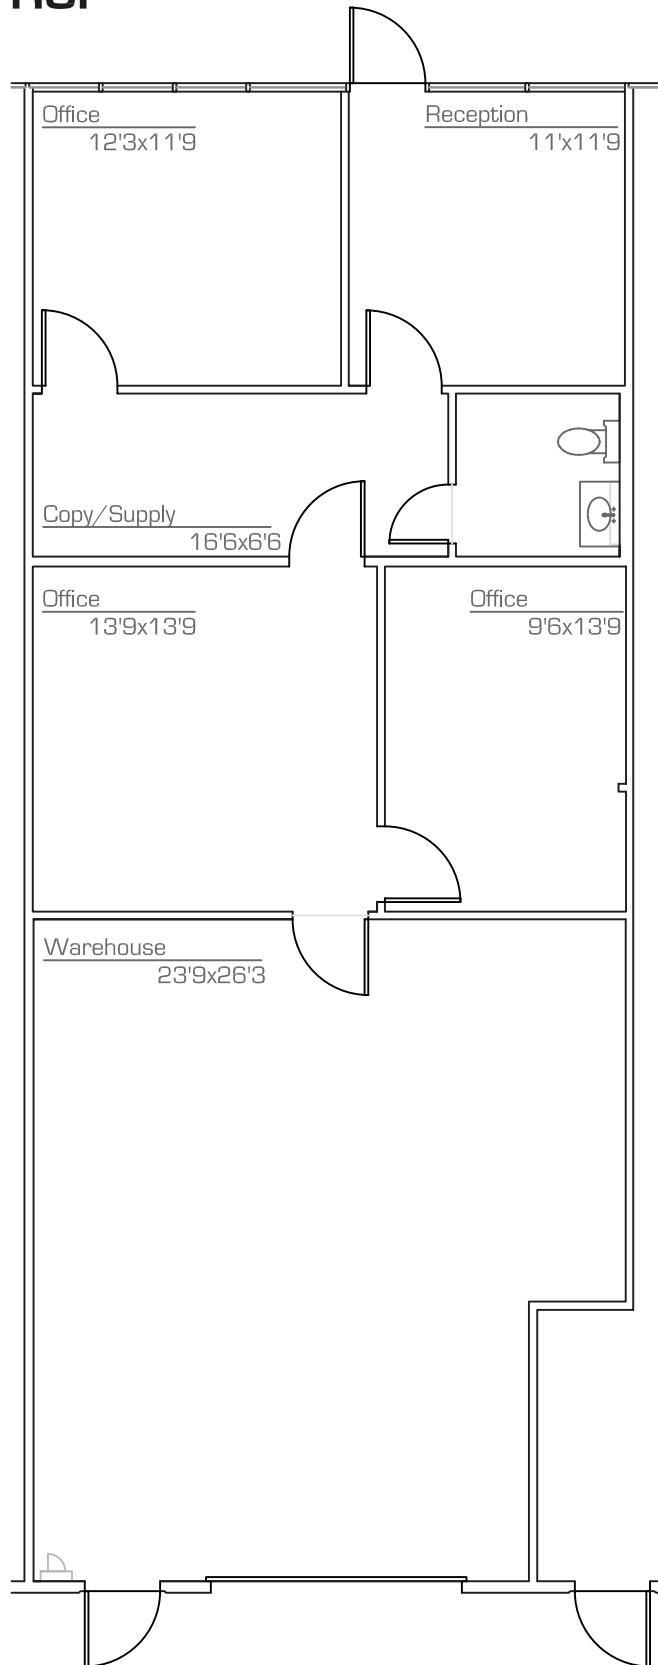

as-built

scale: nts

13.February.2008

*All dimensions are approximate and all information is of general nature.

precision**MEASUREMENTS**



as built . space plans
architectural design

602.790.6412