


# Airport Business Center

537 South 48th Street - Tempe  
Suite 101 - 1,440 RSF

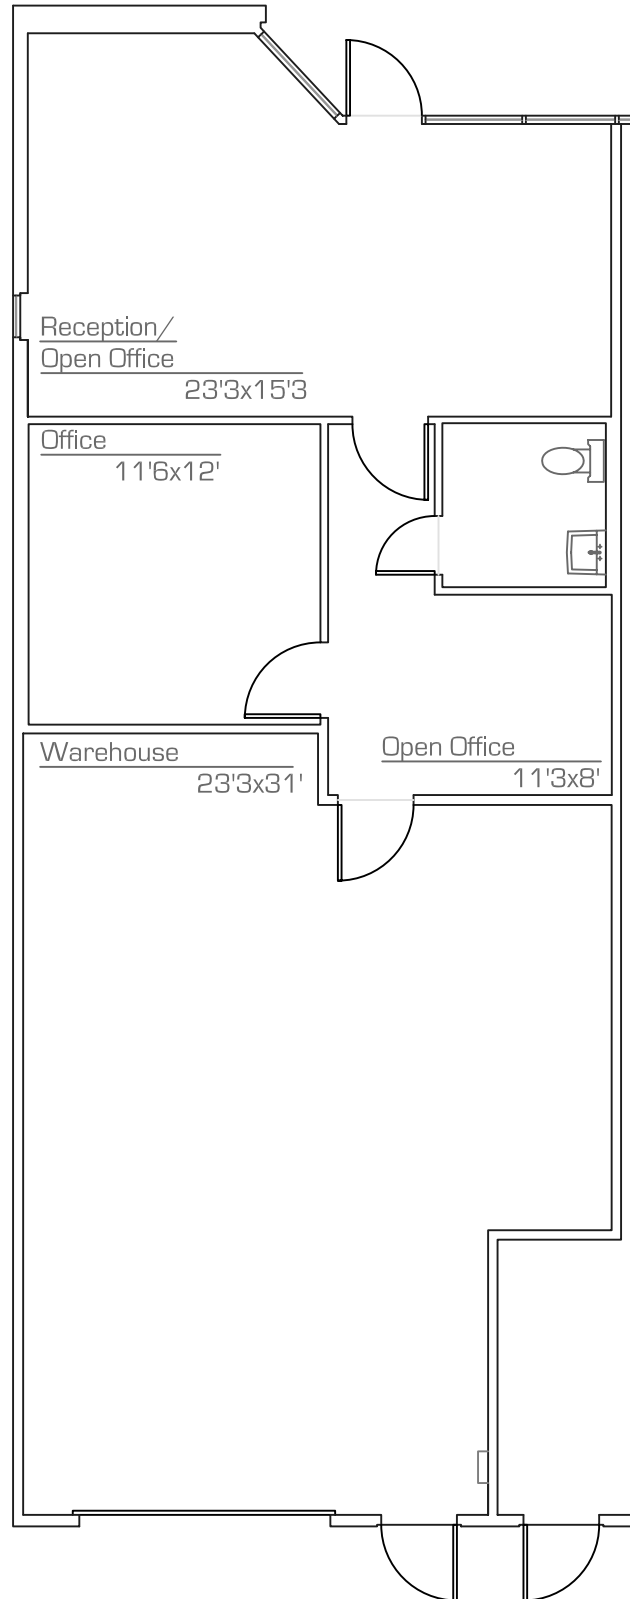


**as-built**

scale: nts  
9.October.2008

\*All dimensions are approximate  
\*All information is of general nature

precision**MEASUREMENTS**

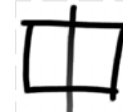

as built . space plans  
architectural design

602.790.6412