


Airport Business Center

537 South 48th Street - Tempe

Suite 103 - 1,200 RSF

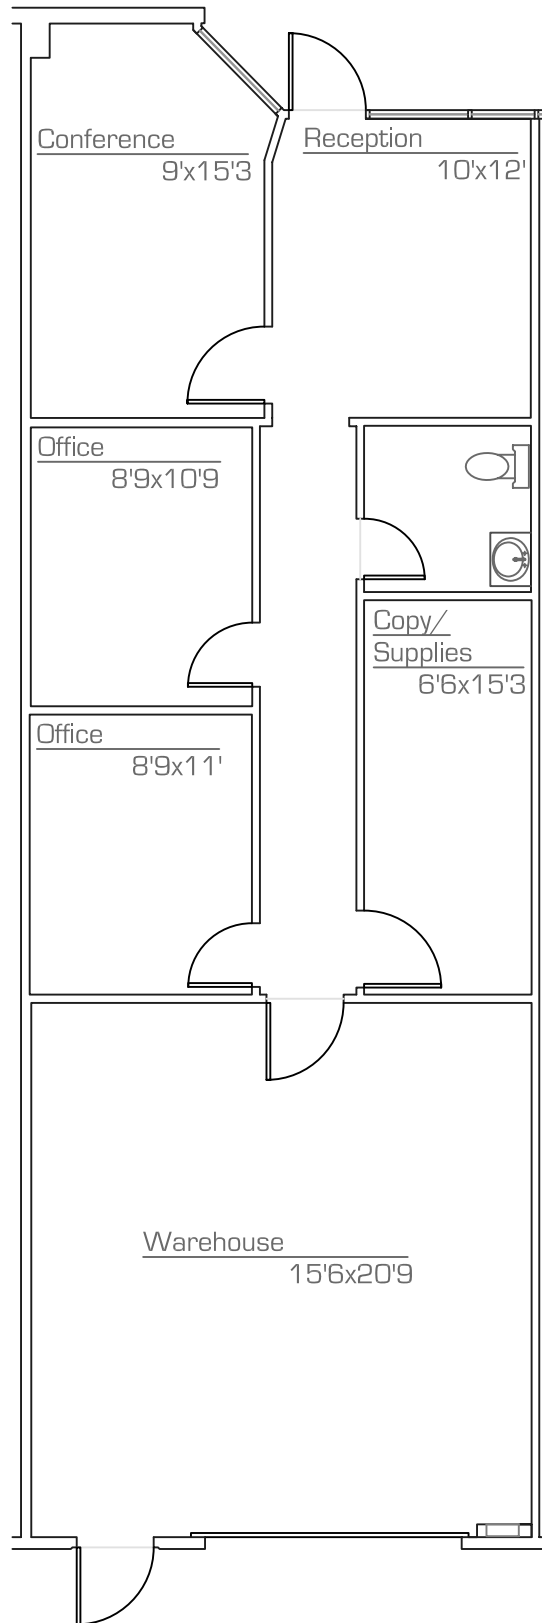

as-built

scale: nts
10.November.2008

*All dimensions are approximate
*All information is of general nature

precision**DIMENSIONS**



as built . space plans
architectural design

602.790.6412