


Airport Business Center

537 South 48th Street - Tempe

Suite 104 - 1,200 RSF

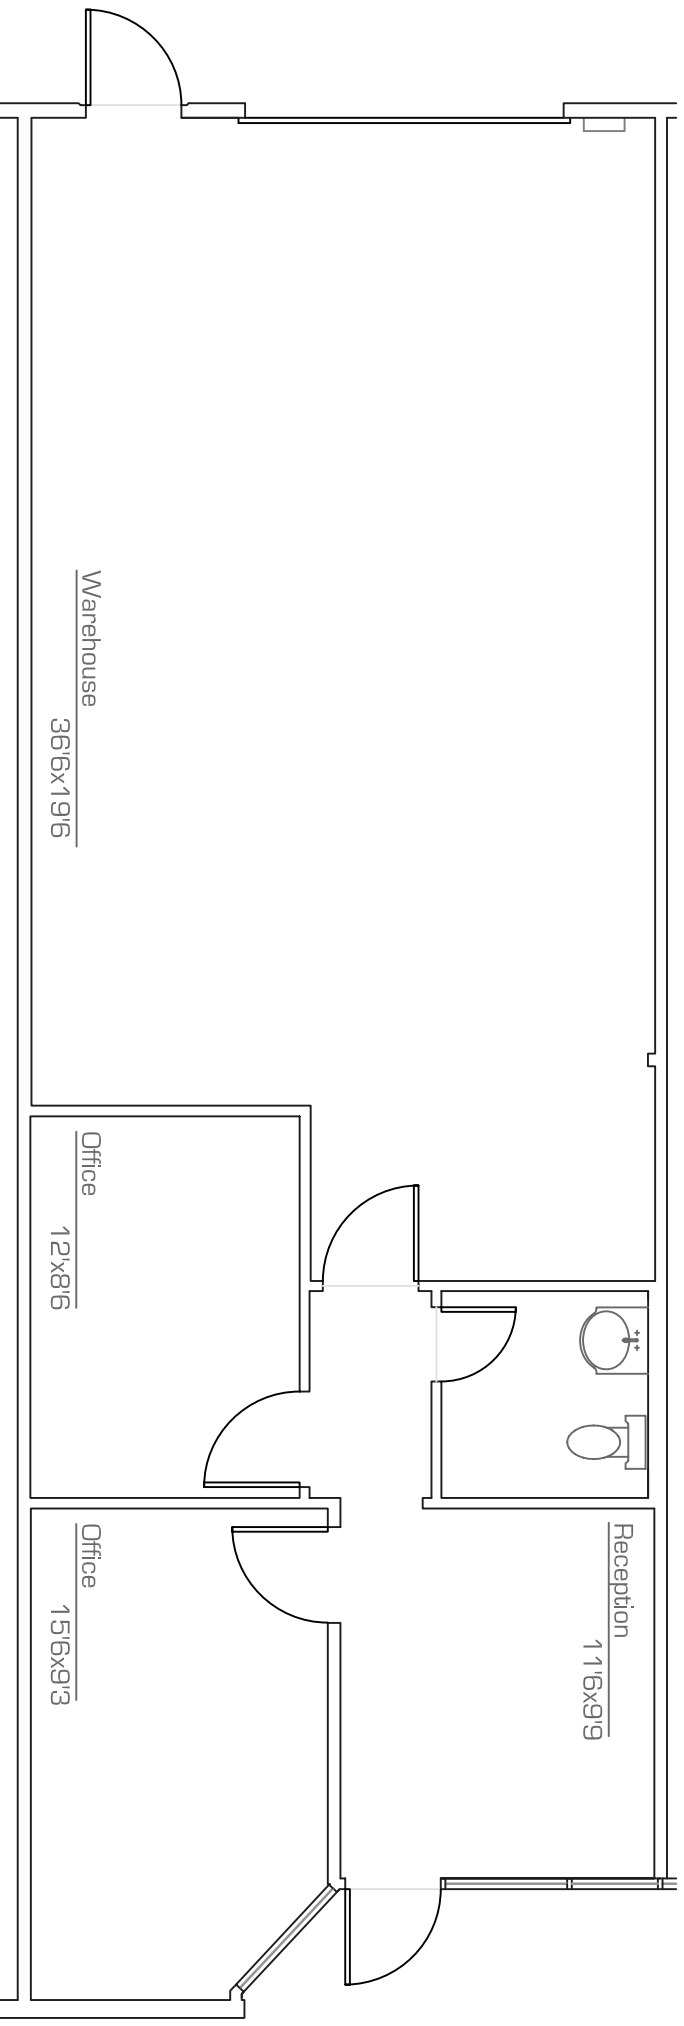

as-built

scale: nts

3.February.2009

*All dimensions are approximate

*All information is of general nature

precision **DIMENSIONS**



as built . space plans
architectural design

602.790.6412