


Airport Business Center

549 South 48th Street - Tempe

Suite 101 - 1,440 RSF

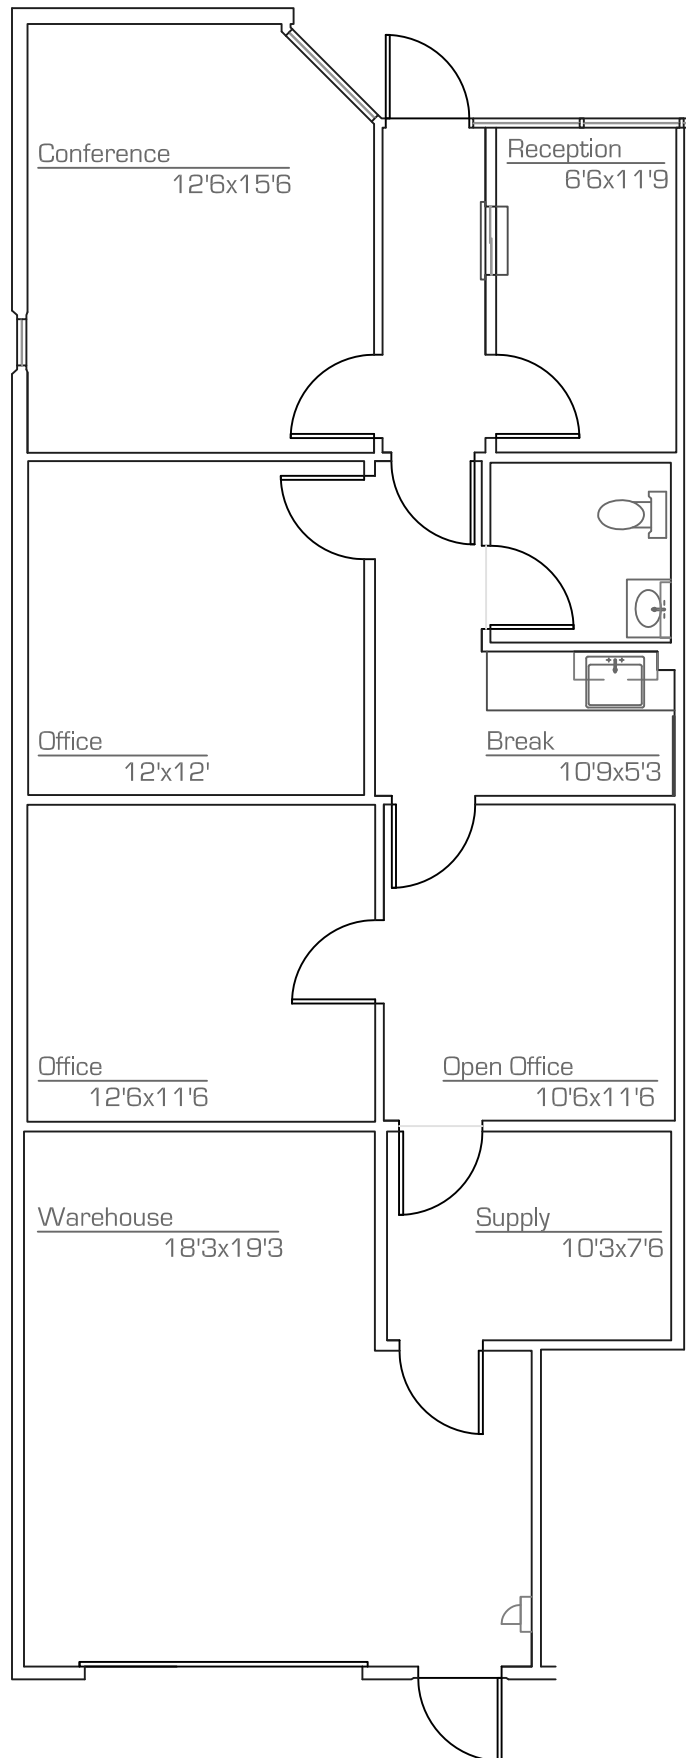

as-built

scale: nts
3.May.2010

*All dimensions are approximate
*All information is of general nature

precision**DIMENSIONS**



as built . space plans
architectural design

602.790.6412