


Airport Business Center

549 South 48th Street - Tempe

Suite 106 - 1,220 RSF

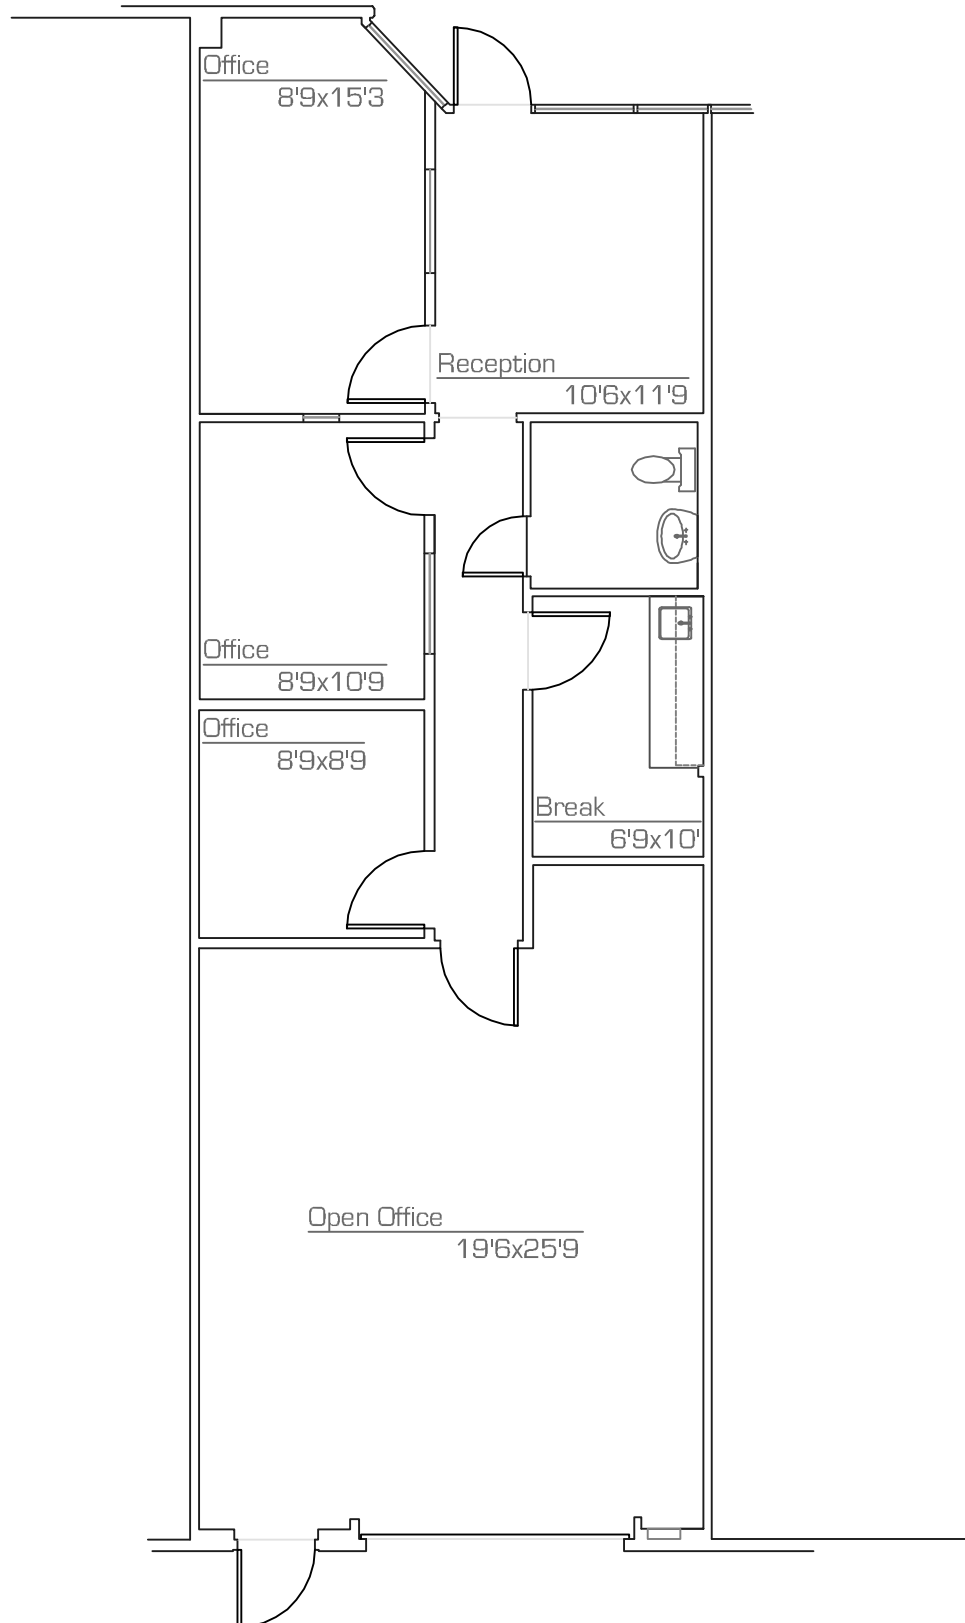

as-built

scale: nts
3.June.2009

*All dimensions are approximate
*All information is of general nature

precision**DIMENSIONS**



as built . space plans
architectural design

602.790.6412