


Airport Business Center

607 South 48th Street . Tempe

Suite 104 - 1,728 RSF

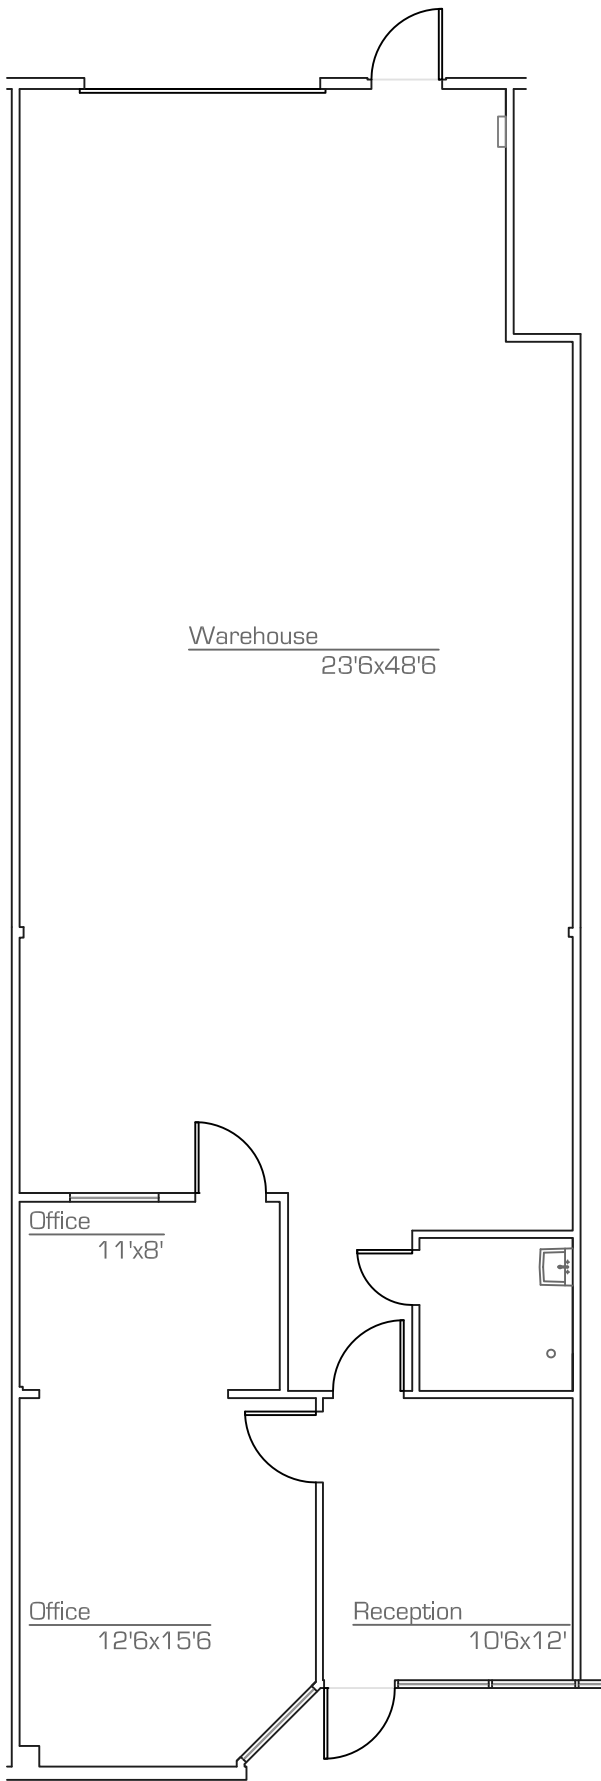

as-built

scale: nts
3.May.2010

*All dimensions are approximate
*All information is of general nature

precision**DIMENSIONS**



as built . space plans
architectural design

602.790.6412