


Airport Business Center

607 South 48th Street . Tempe

Suite 105 - 1,728 RSF

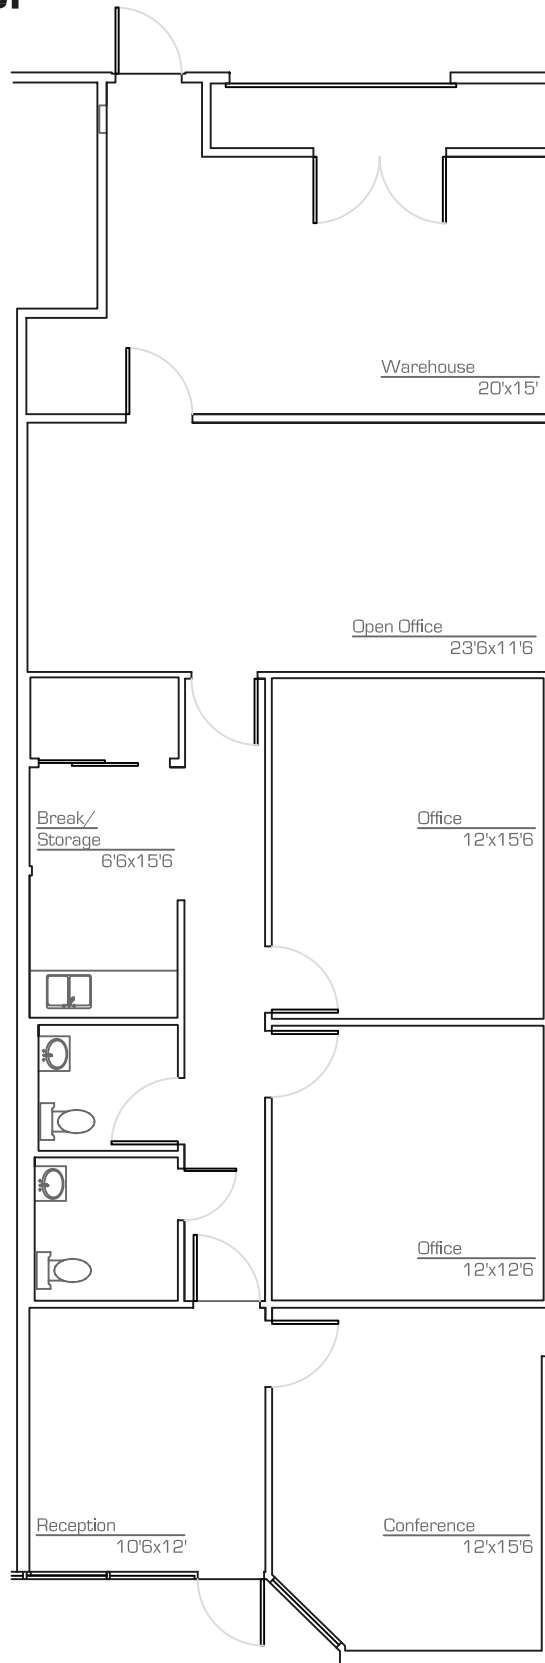


as-built

scale: nts

20.July.2007

*All dimensions are approximate and all information is of general nature.

precision**MEASUREMENTS**

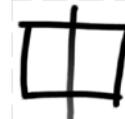

as built . space plans
architectural design

602.790.6412