


# Airport Business Center

621 South 48th Street - Tempe

Suite 103 - 1,920 RSF

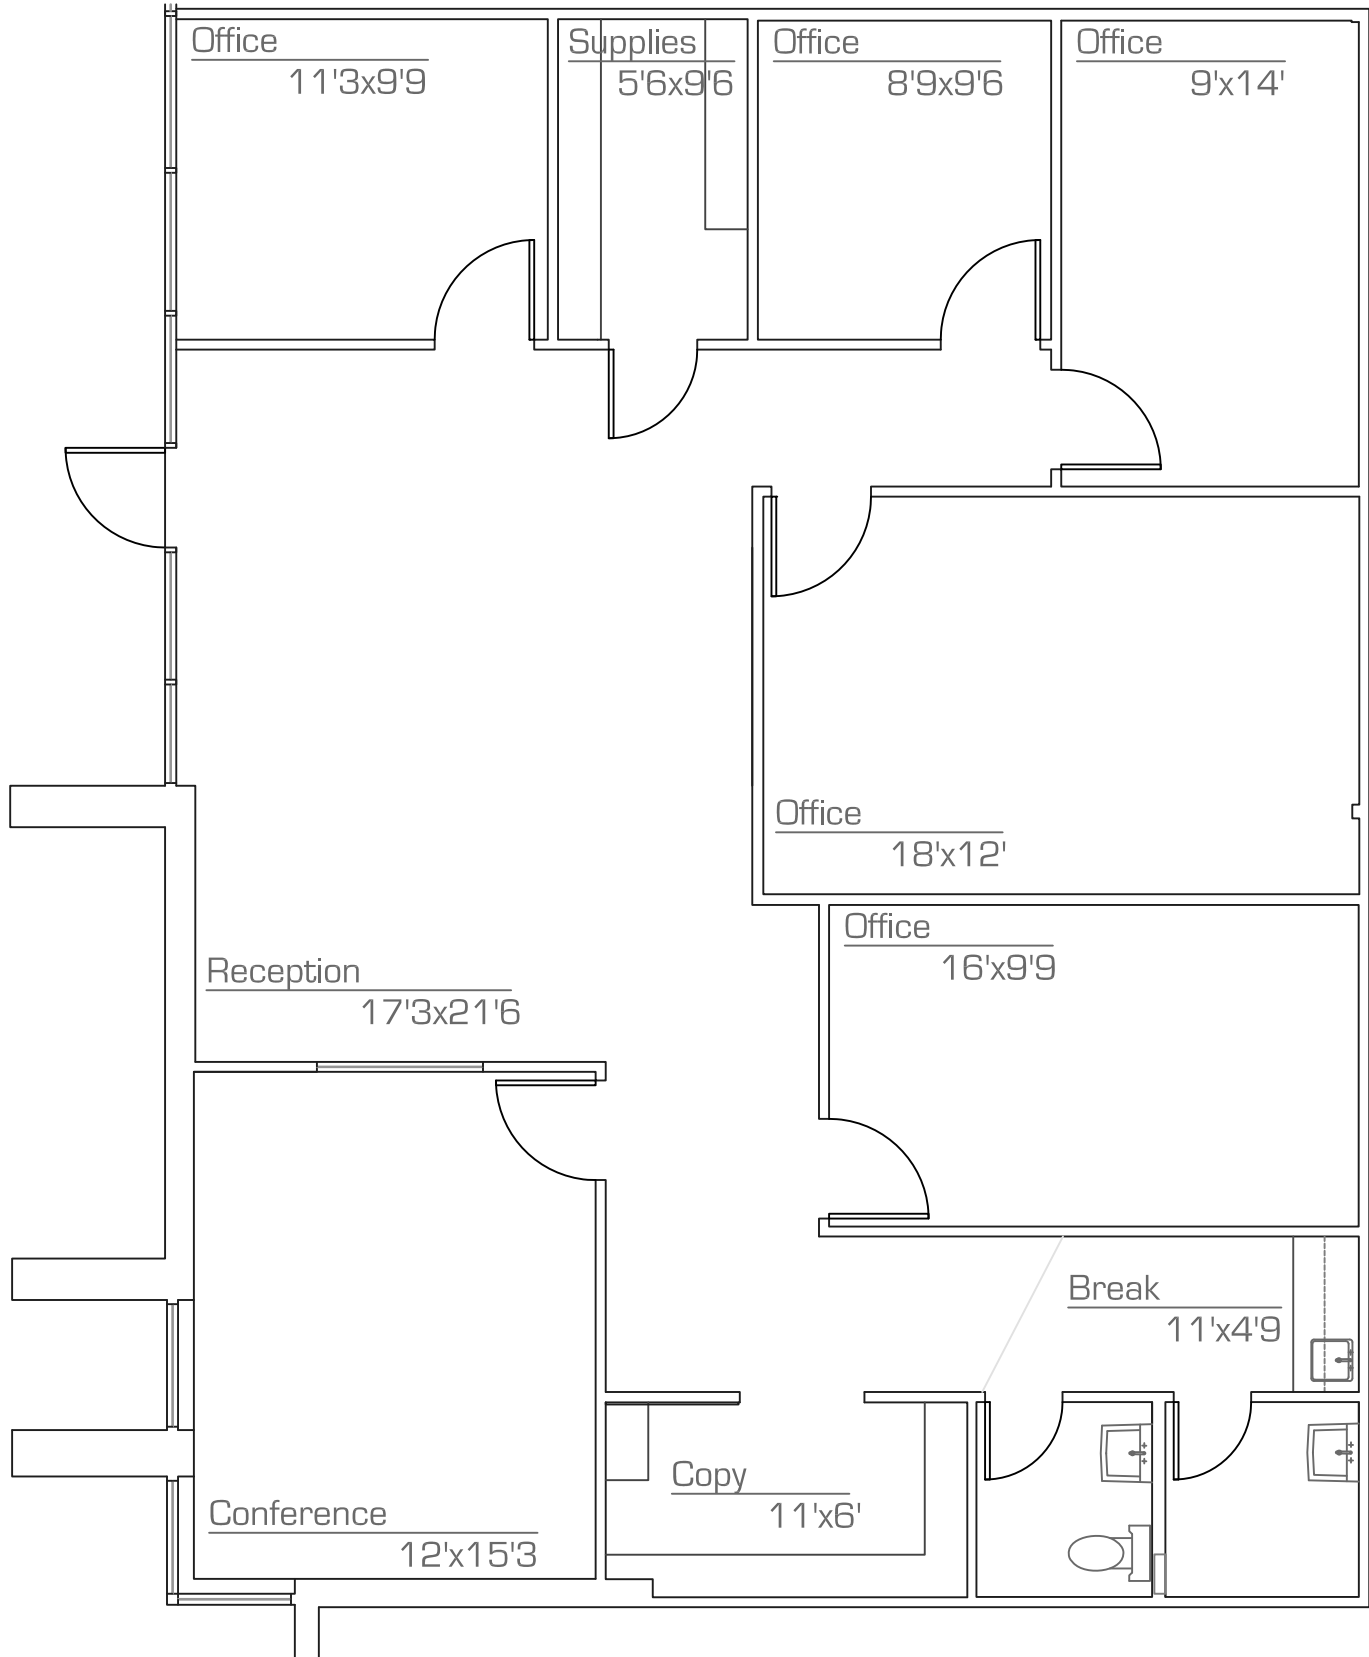

**as-built**

scale: nts  
23.March.2009

\*All dimensions are approximate  
\*All information is of general nature

precision**DIMENSIONS**



as built . space plans  
architectural design

602.790.6412