
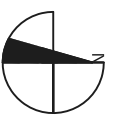


Airport Business Center

621 South 48th Street . Tempe

Suite 105 - 960 RSF

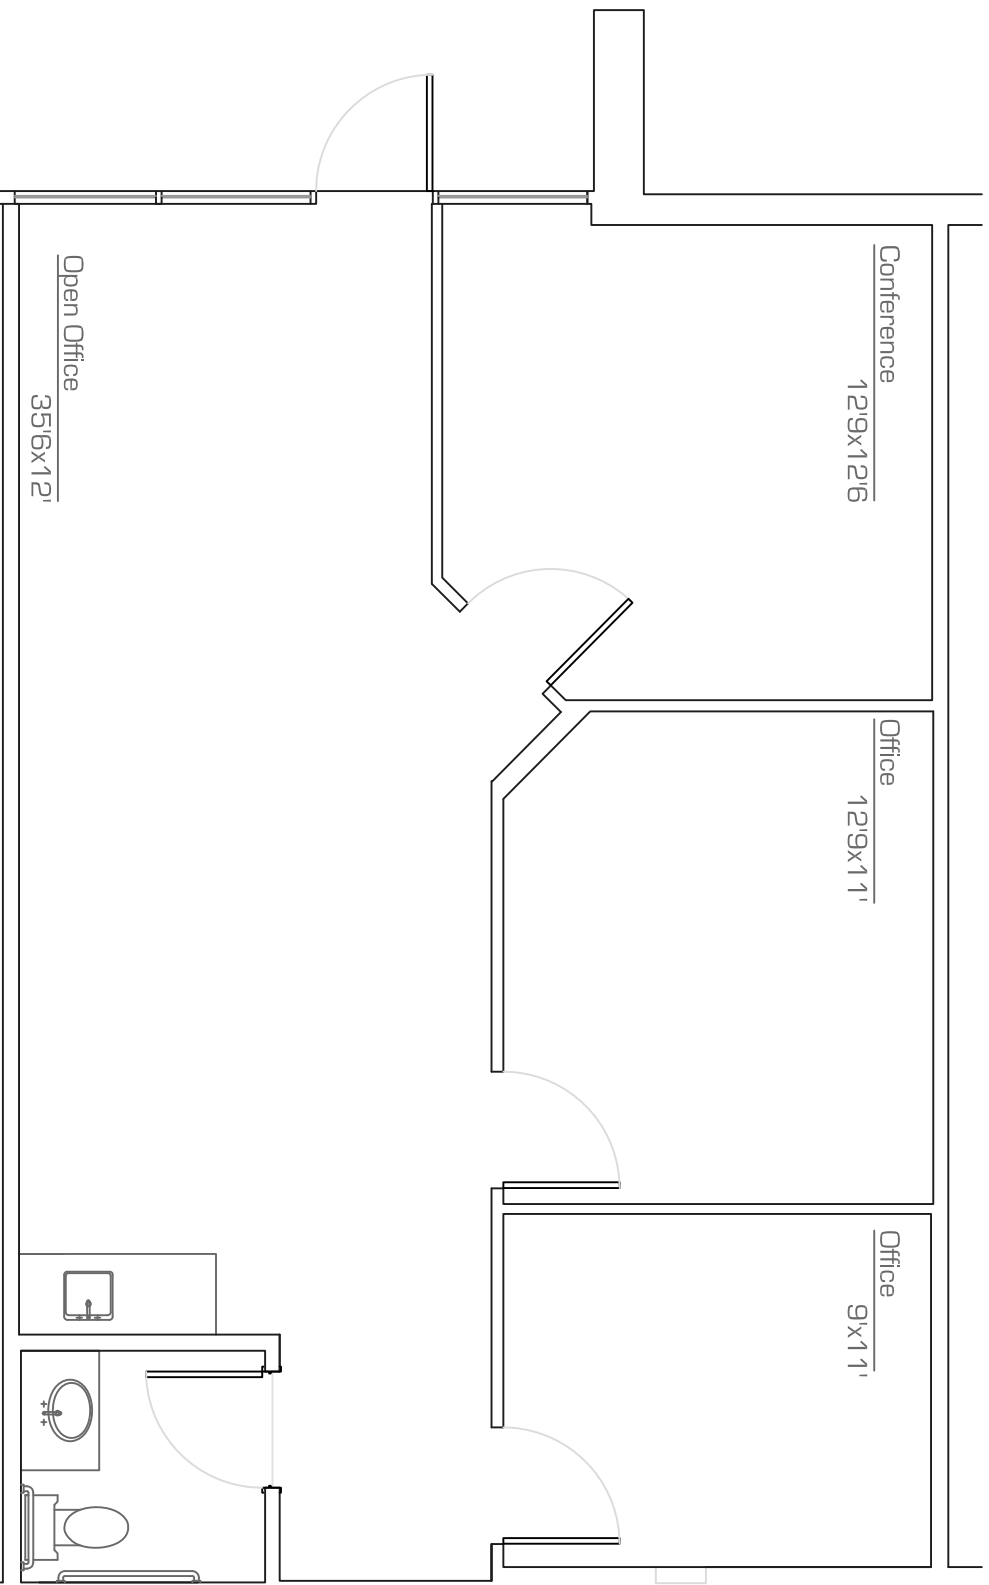

as-built

scale: nts

14.April.2009

*All dimensions are approximate
*All information is of general nature.

precision **DIMENSIONS**



as built . space plans
architectural design

602.790.6412