


Airport Business Center Phase I

621 South 48th Street . Tempe

Suite 116 - 720 RSF

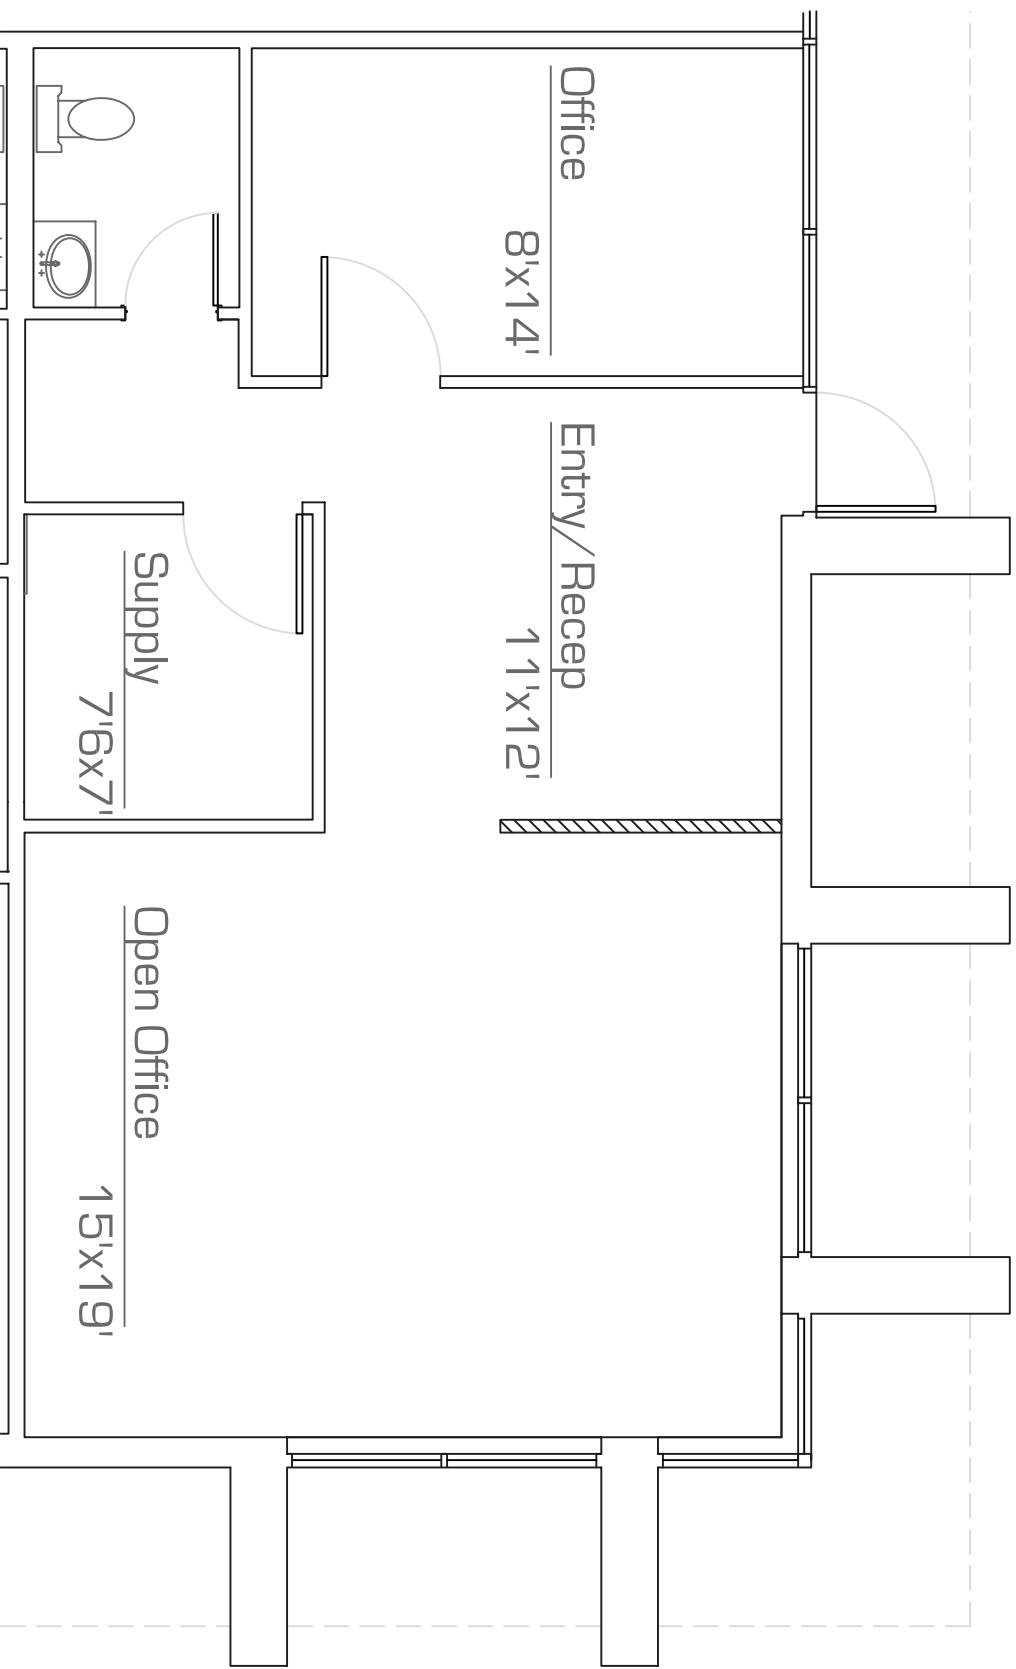

as-built

scale: nts

7.November.2006

*All dimensions are approximate and all information is of general nature.



precision**MEASUREMENTS**

as built . space plans
architectural design

602.790.6412

