


# Airport Business Center

627 South 48th Street - Tempe

Suite 100 - 4,973 RSF

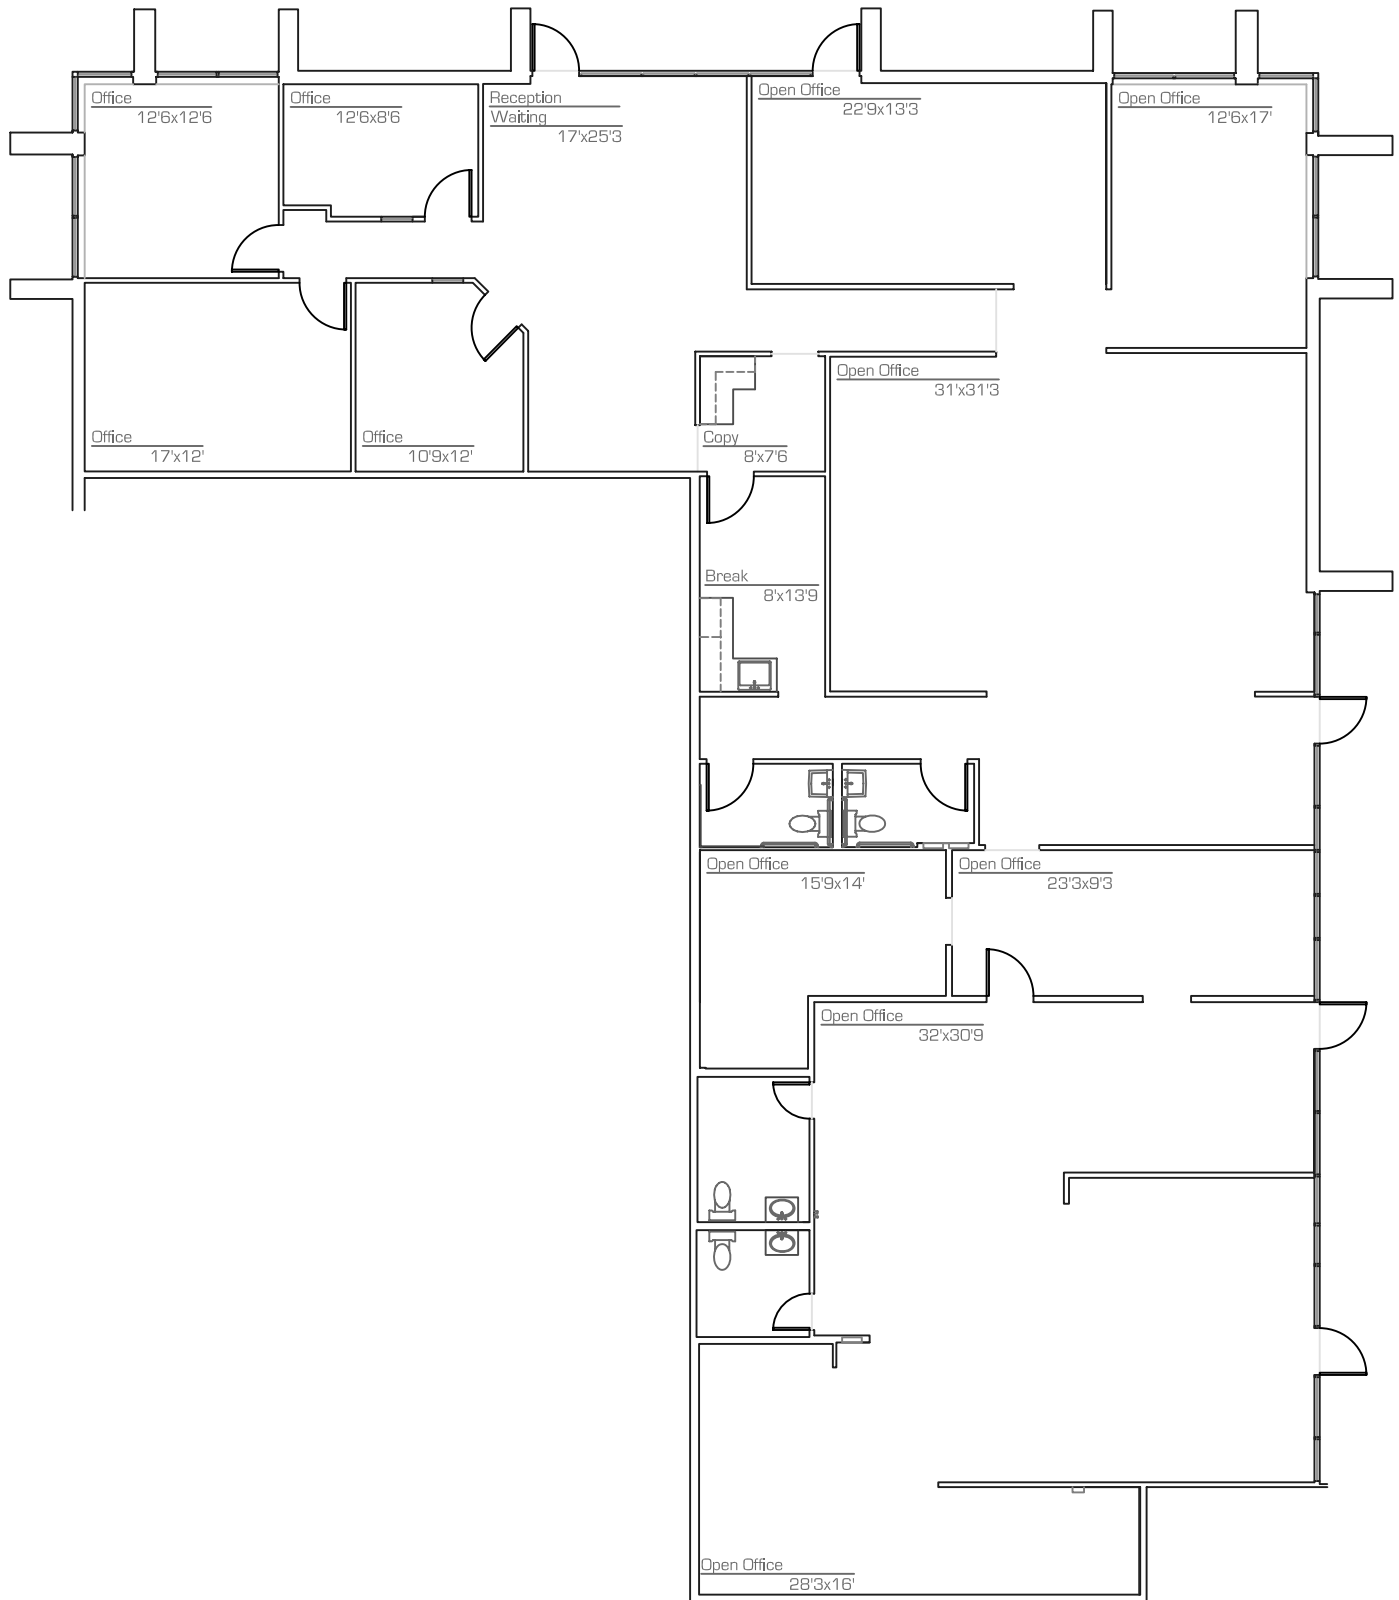


**as-built**

scale: nts  
10.February.2009

\*All dimensions are approximate  
\*All information is of general nature

precision**DIMENSIONS**

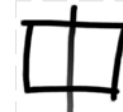

as built . space plans  
architectural design

602.790.6412