


# Airport Business Center Executive Suites

637 South 48th Street . Tempe

Suite 21 - 187 RSF

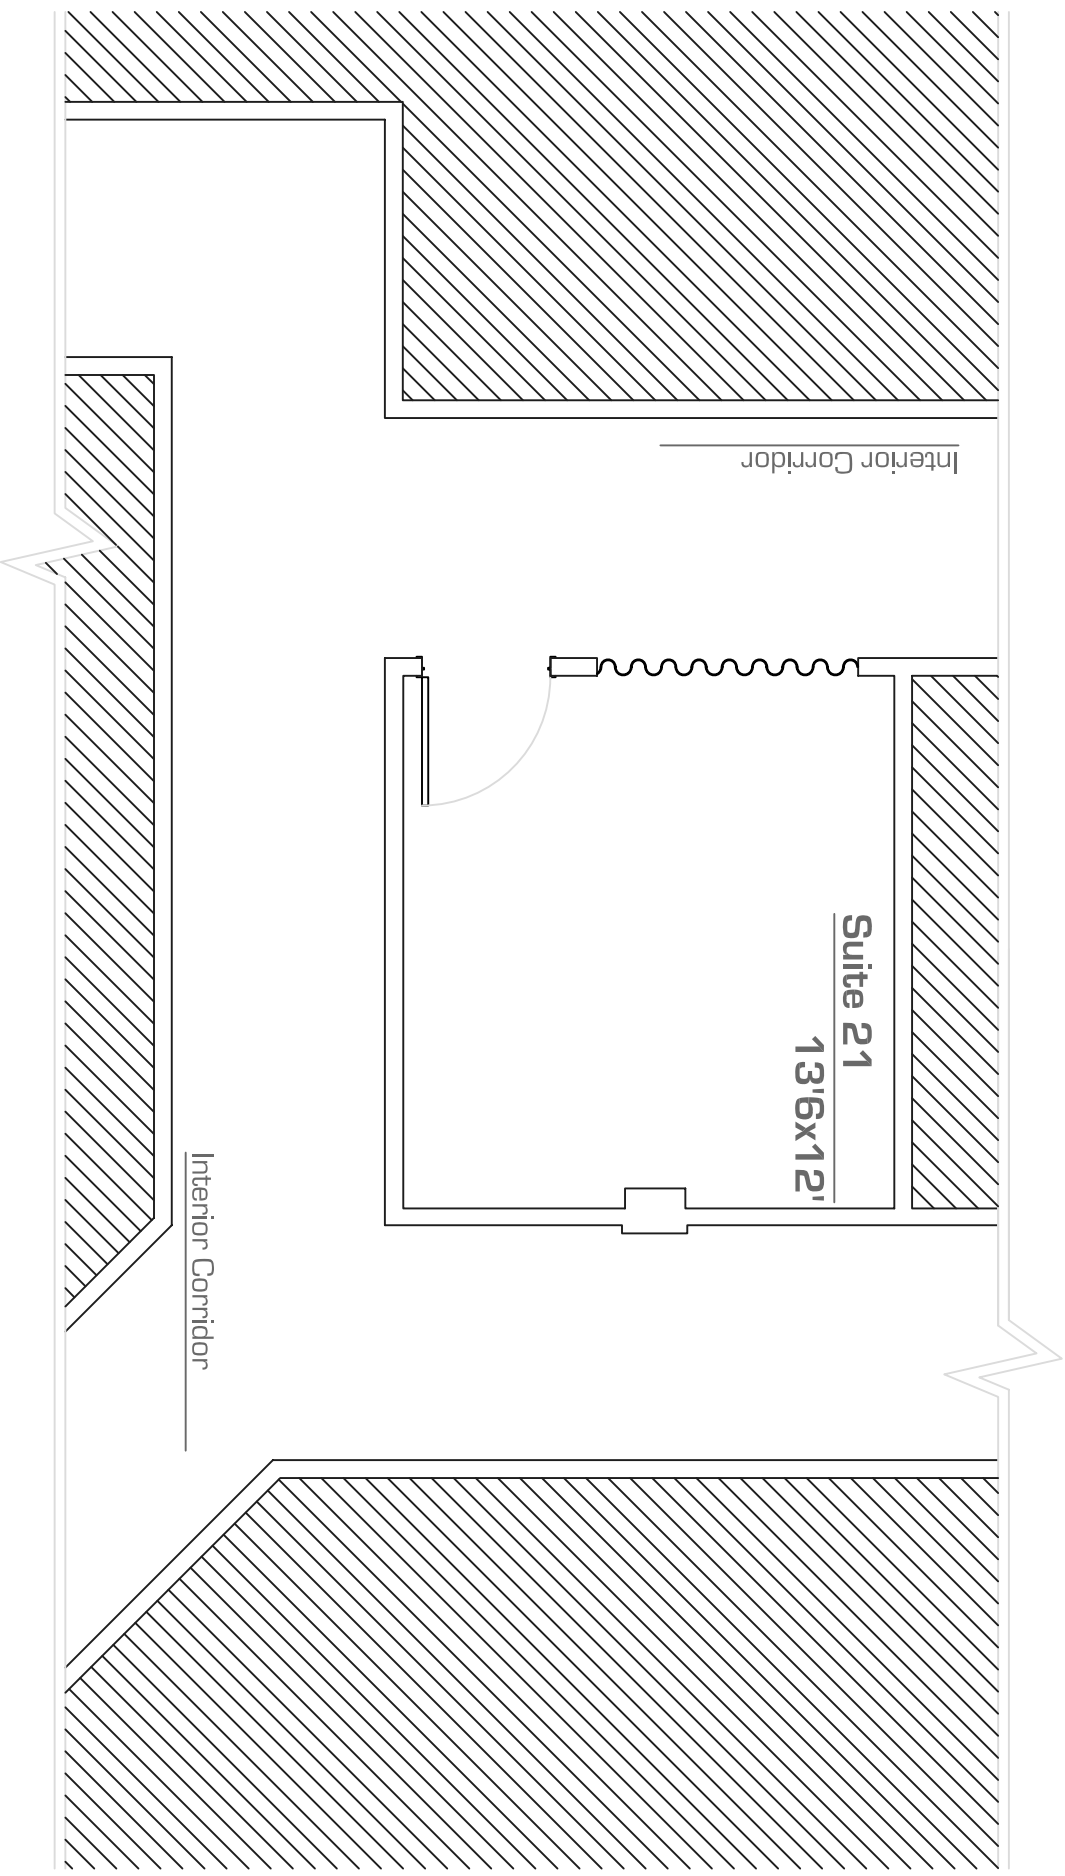

**as-built**

scale: nts

19.january.2007

\*All dimensions are approximate and all information is of general nature.

precision **MEASUREMENTS**

as built . space plans  
architectural design

602.790.6412

