


# Airport Business Center

325 South 48th Street - Tempe  
Suite 108 - 2,553 RSF

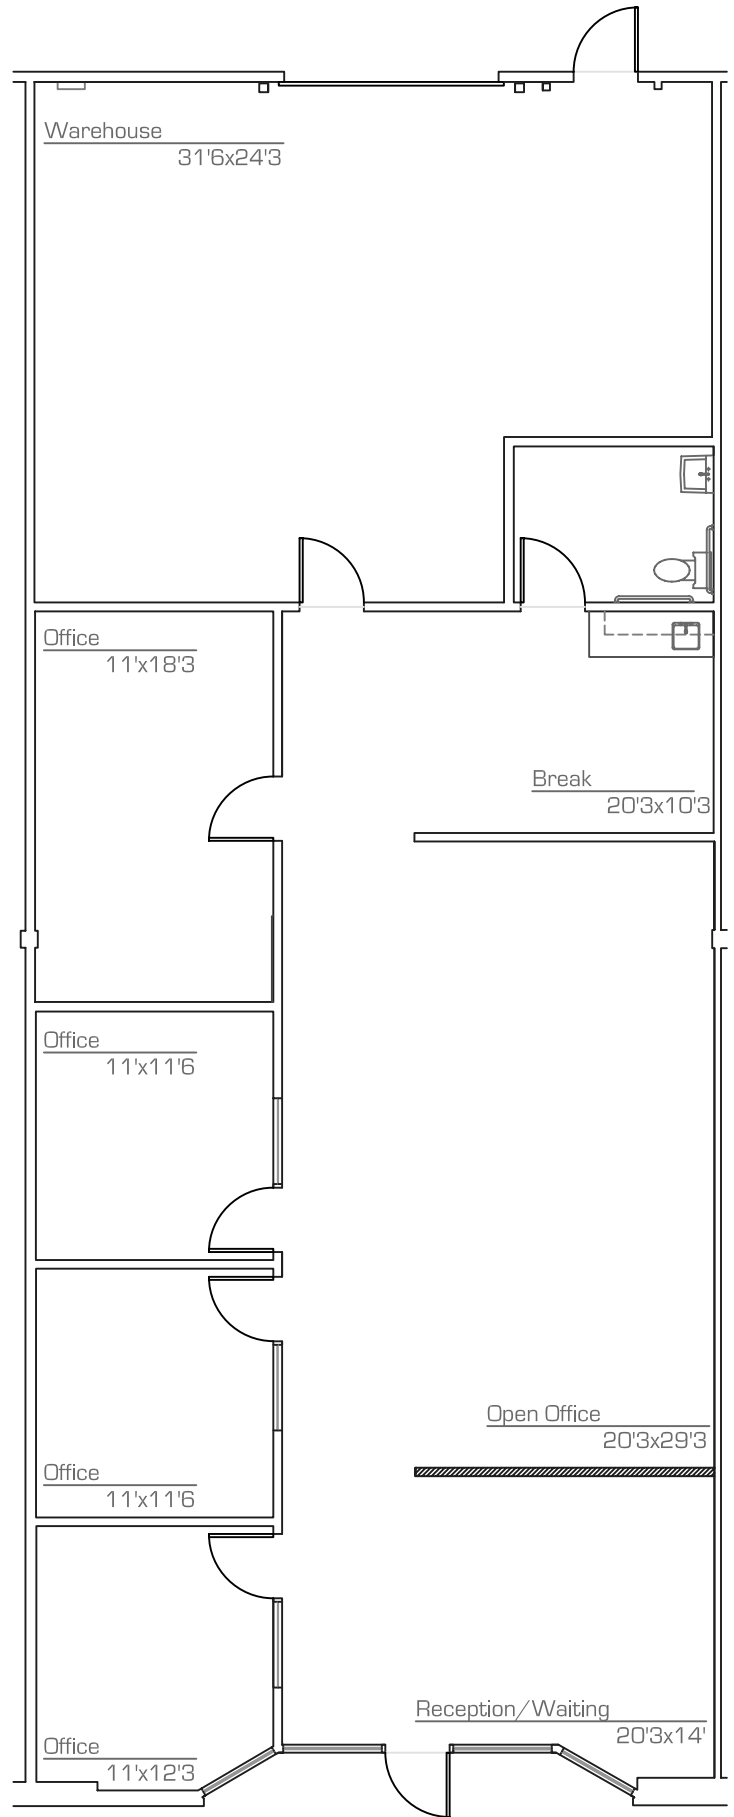


**as-built**

scale: nts  
18.December.2008

\*All dimensions are approximate  
\*All information is of general nature

precision**DIMENSIONS**

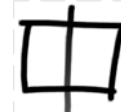

as built . space plans  
architectural design

602.790.6412