


# Airport Business Center

415 South 48th Street

Suite 110 - 4,321 RSF

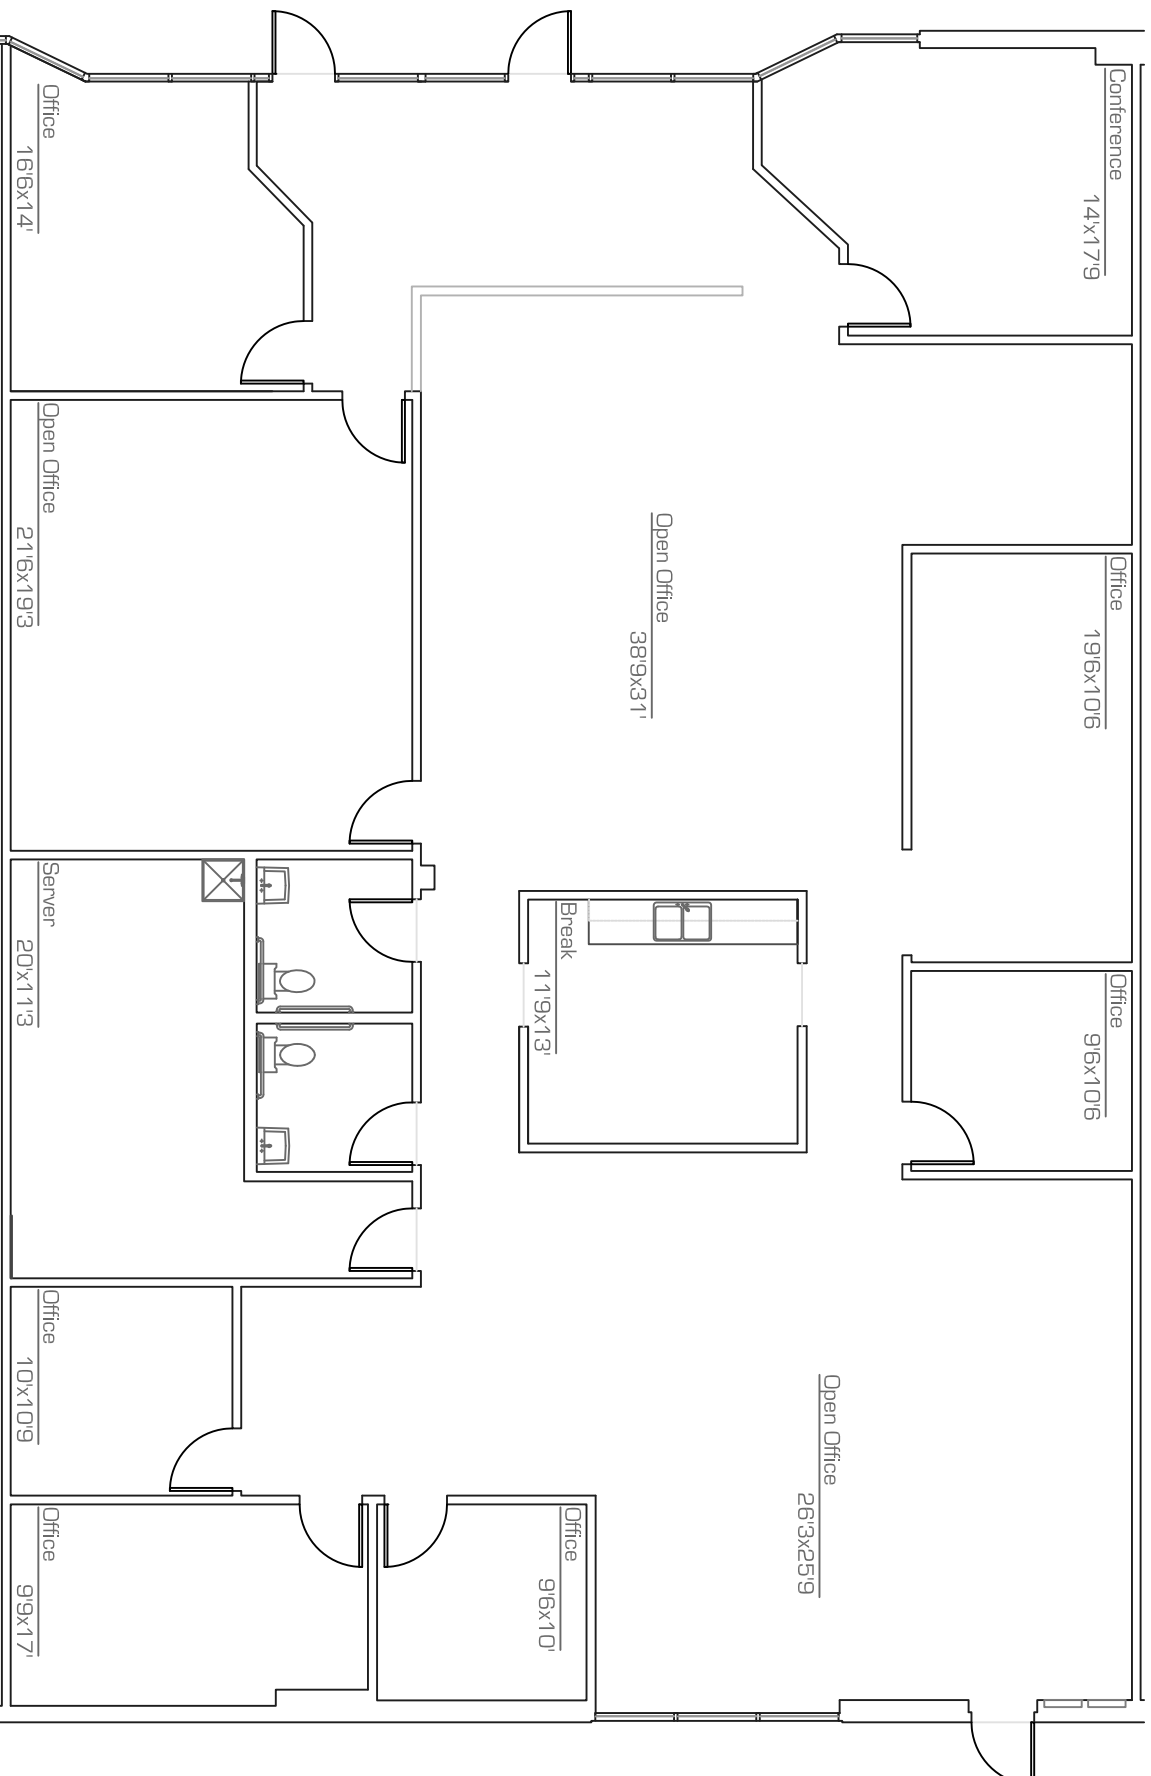

**as-built**

scale: nts

19.January.2010

\* All dimensions are approximate

\* All information is of general nature



**precision DIMENSIONS**

as built . space plans  
architectural design

602.790.6412

