


Airport Business Center

425 South 48th Street - Tempe
Suite 108 - 7,260 RSF

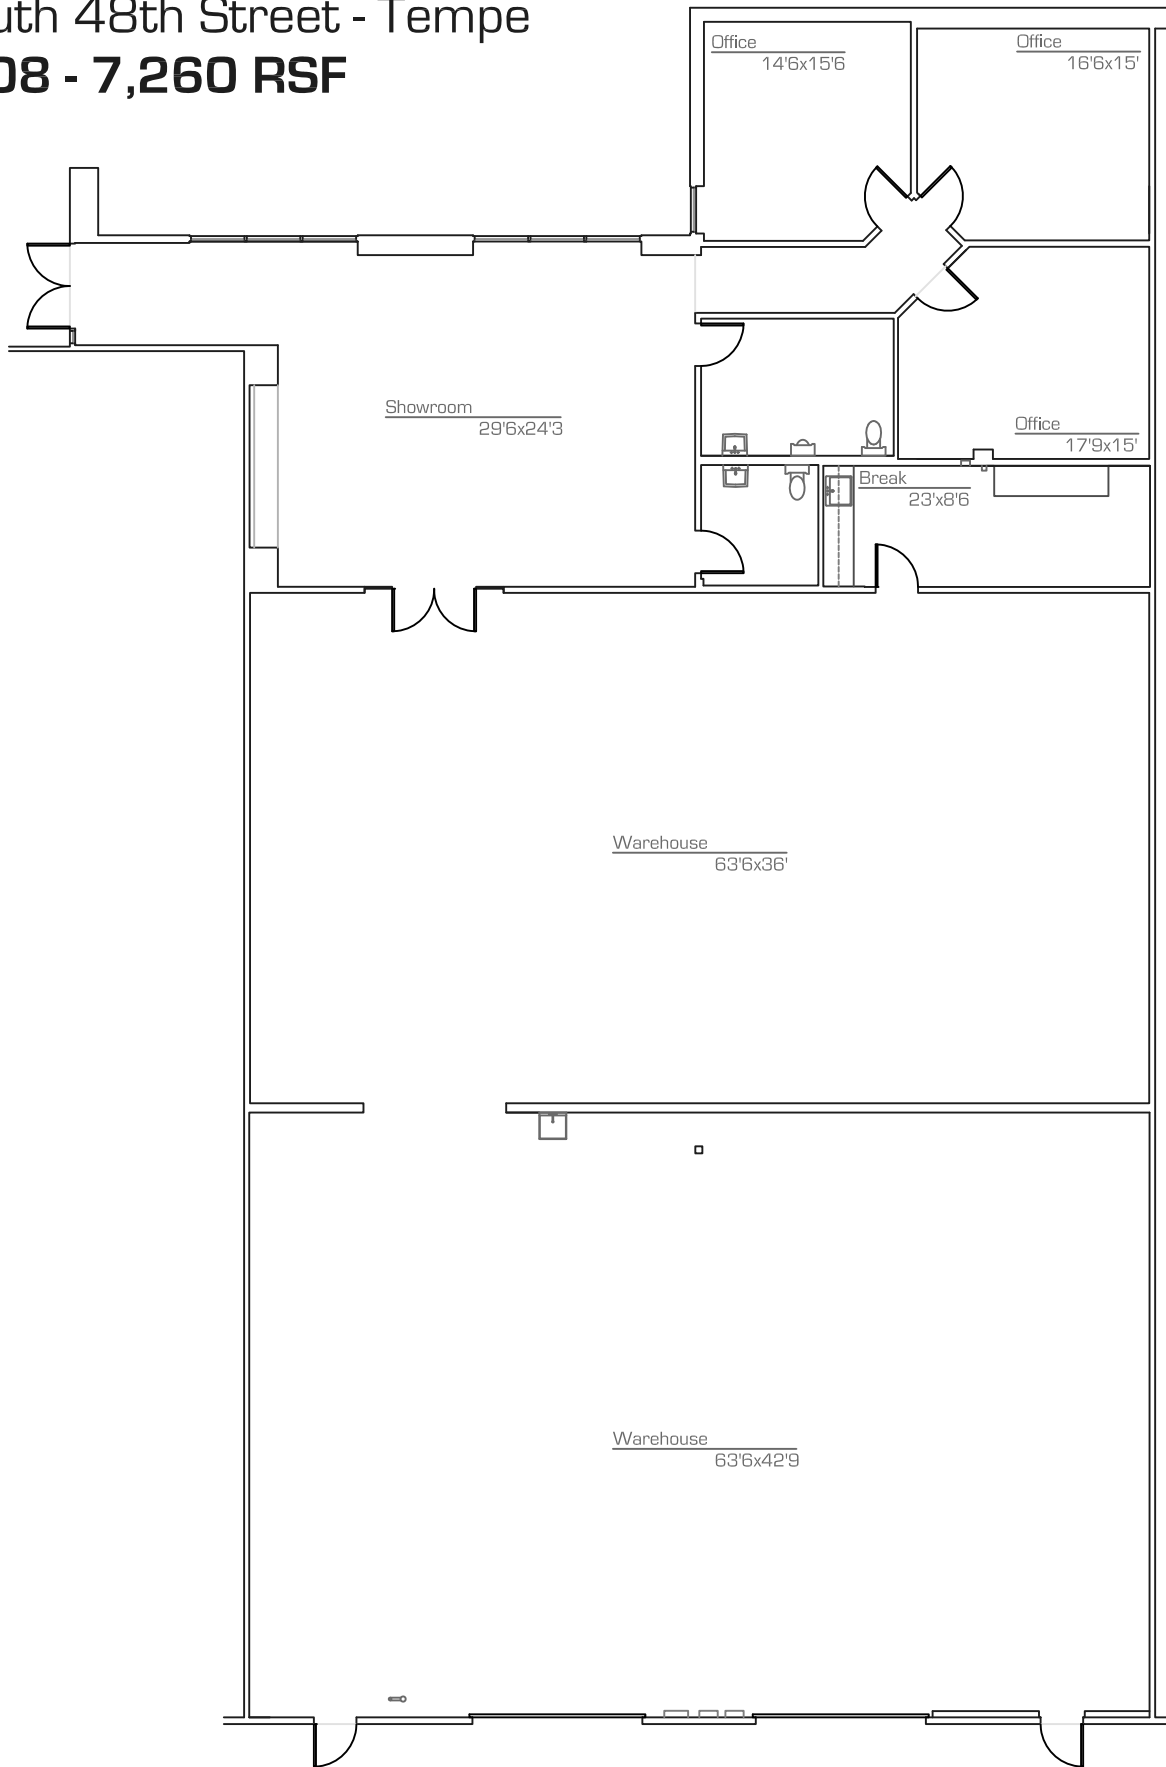

as-built

scale: nts
21.August.2009

*All dimensions are approximate
*All information is of general nature

precision**DIMENSIONS**



as built . space plans
architectural design

602.790.6412