


Airport Business Center

425 South 48th Street - Tempe

Suite 110 - 5,627 RSF

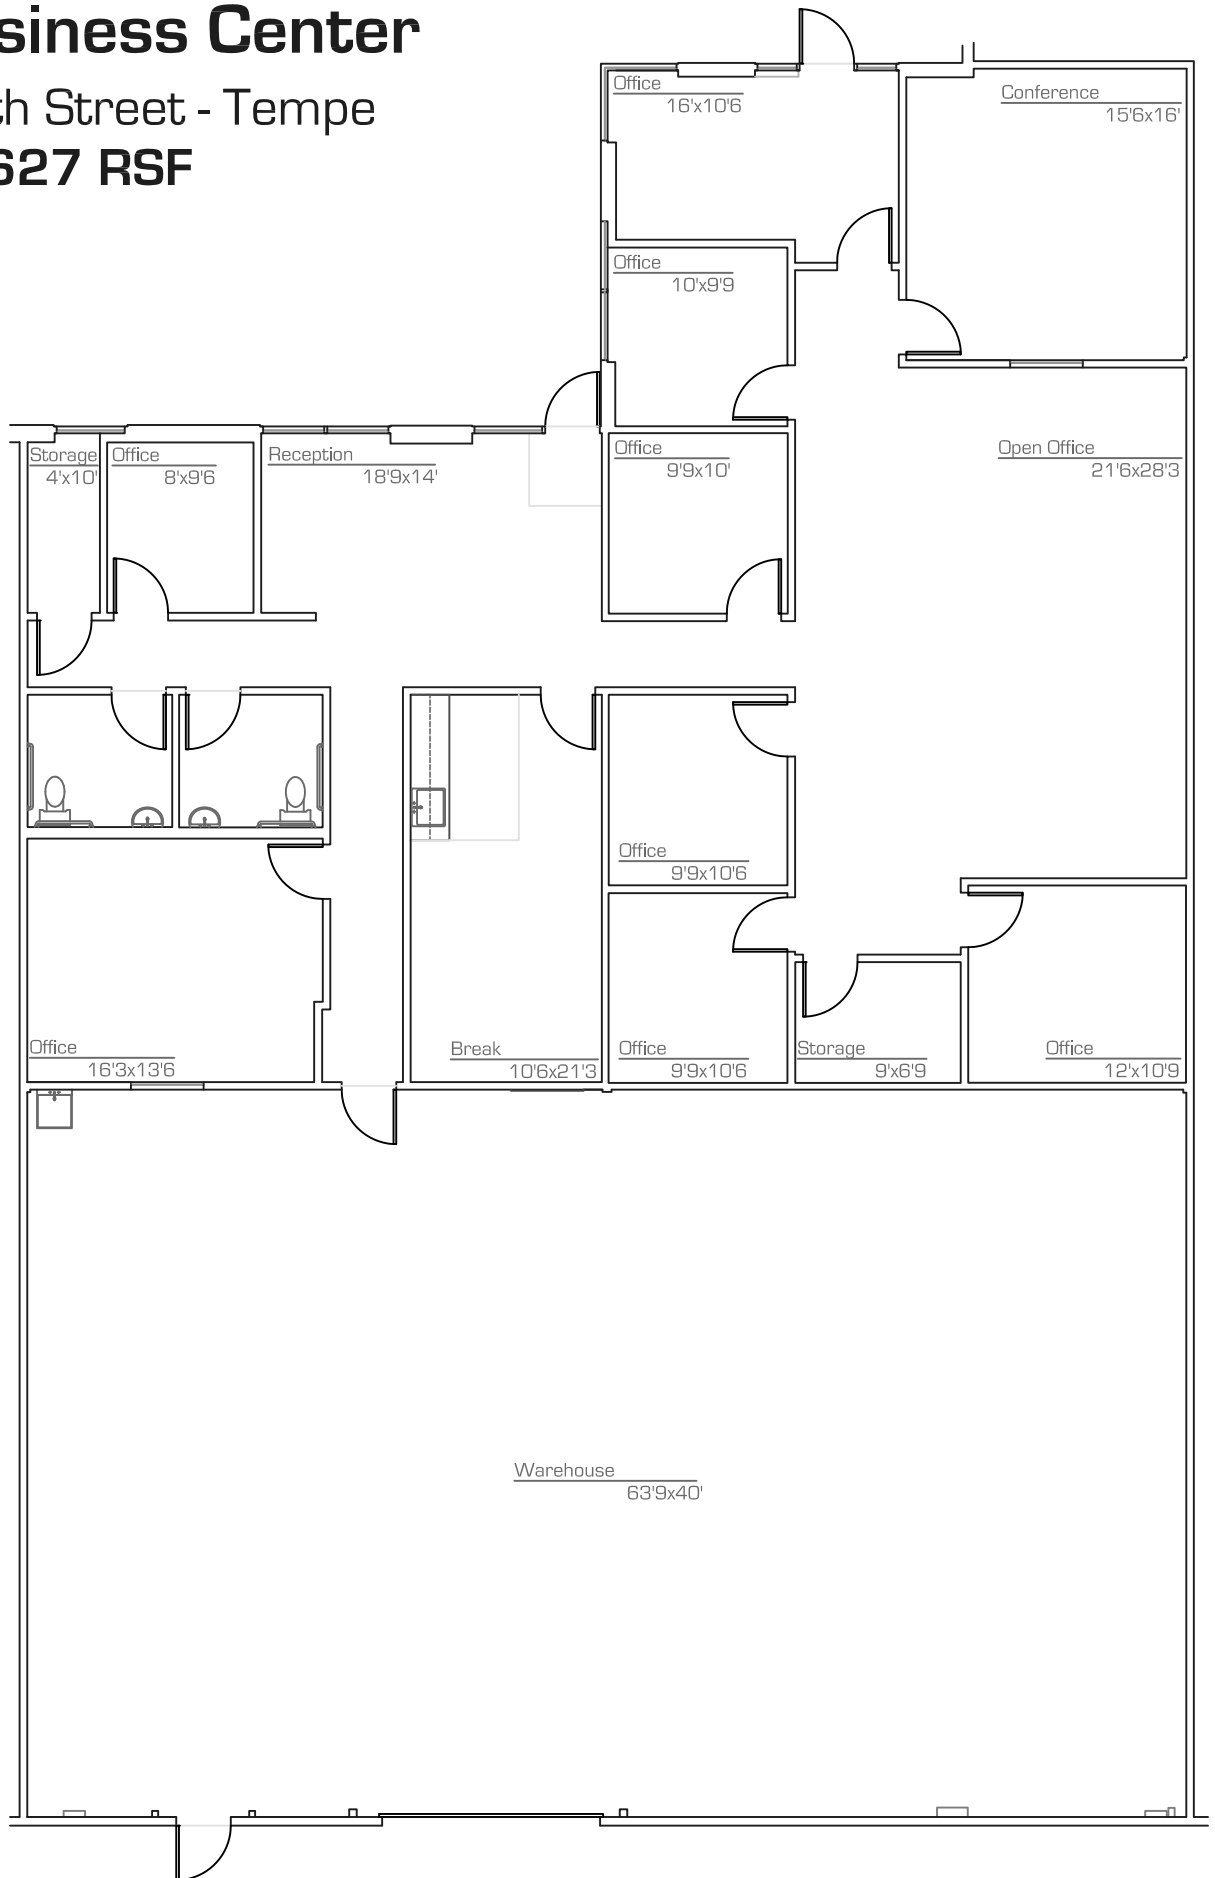


as-built

scale: nts
17.July.2009

*All dimensions are approximate
*All information is of general nature

precision**DIMENSIONS**

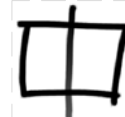

as built . space plans
architectural design

602.790.6412