


Airport Plaza

939 South 48th Street - Tempe

Suite 204 - 1,356 RSF

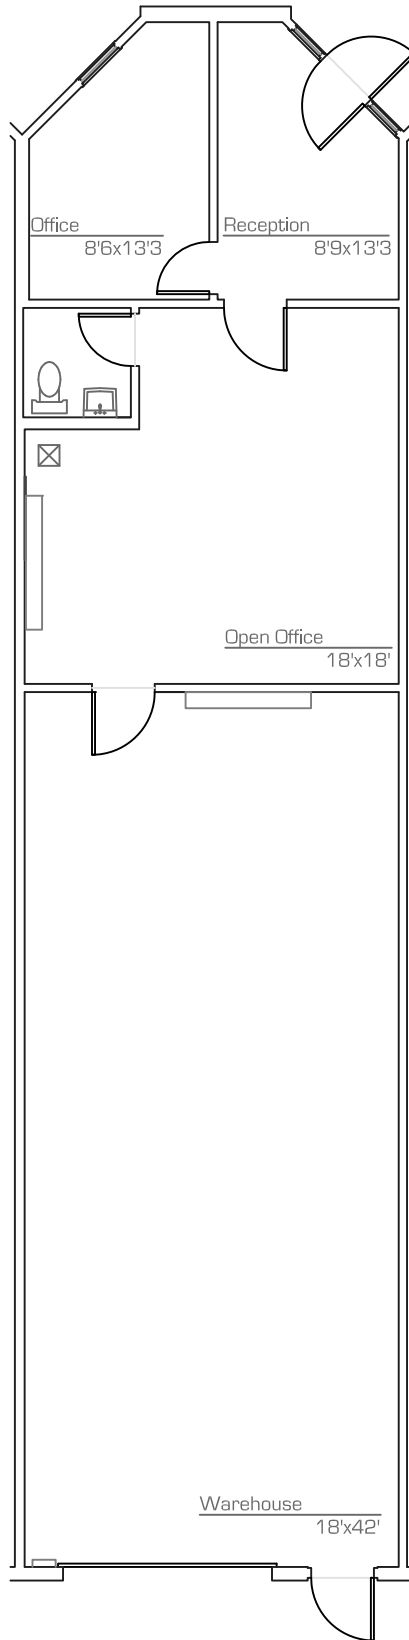


as-built

scale: nts
19.January.2010

*All dimensions are approximate
*All information is of general nature

precision**DIMENSIONS**

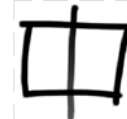

as built . space plans
architectural design

602.790.6412