


# Airport Plaza

939 South 48th Street - Tempe  
Suite 206 - 1,660 RSF

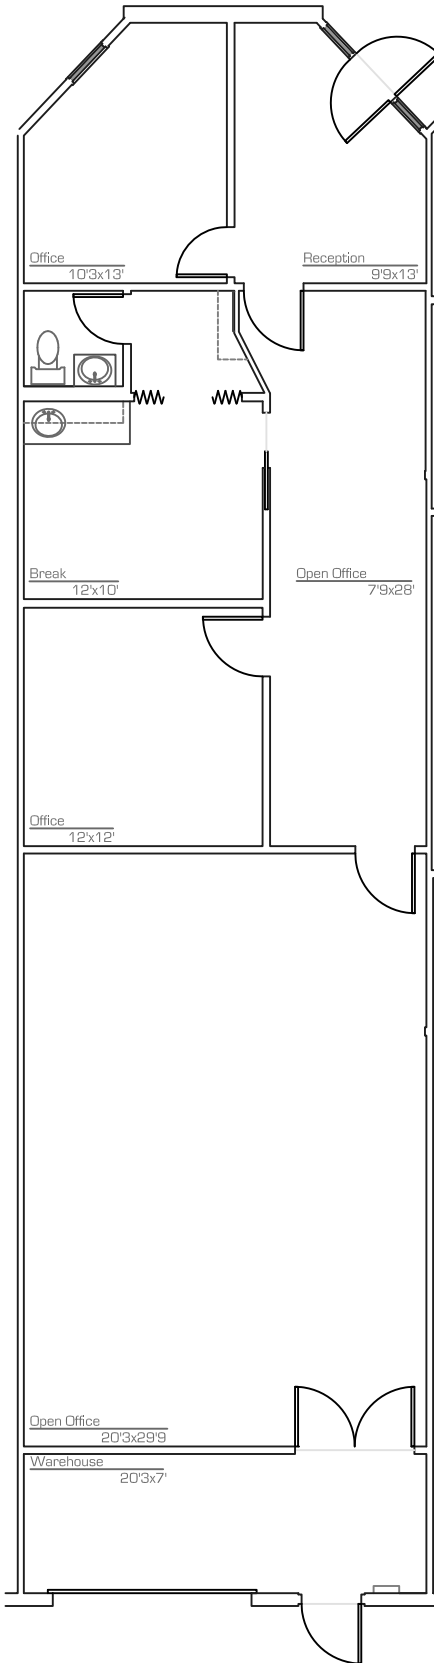

**as-built**

scale: nts  
25.September.2009

\*All dimensions are approximate  
\*All information is of general nature

precision**DIMENSIONS**



as built . space plans  
architectural design

602.790.6412