


# Airport Plaza

939 South 48th Street . Tempe  
Suite 210 - 1,763 RSF

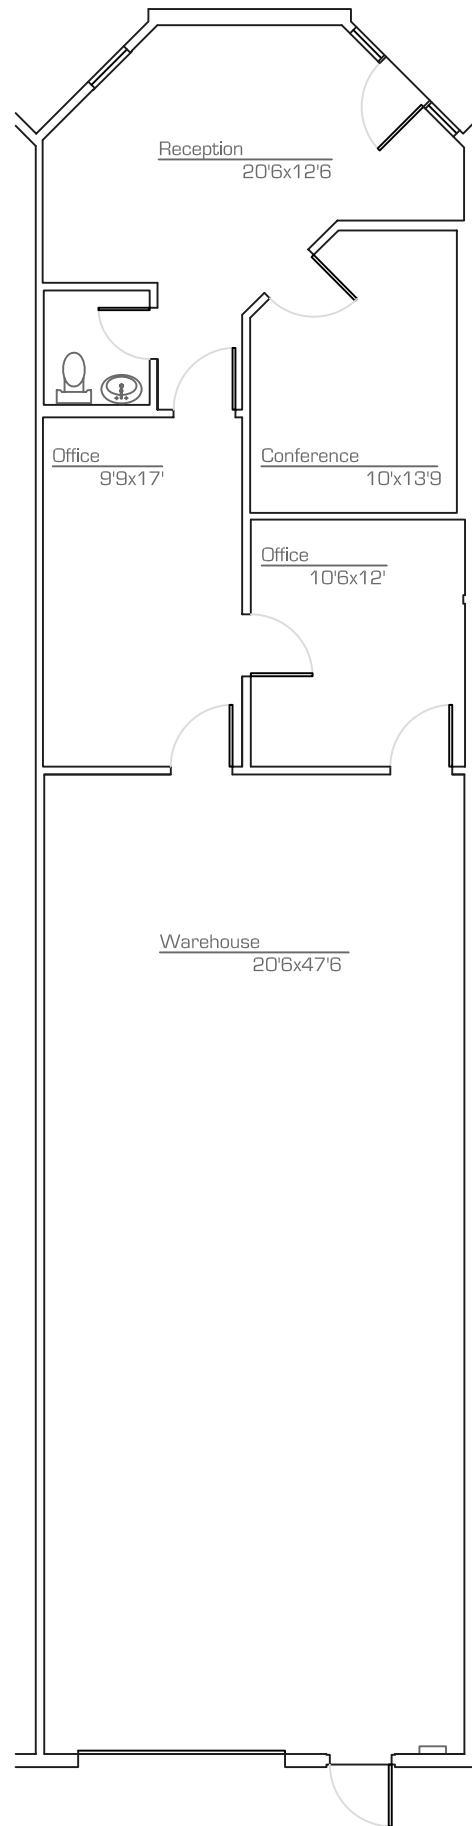

**as-built**

scale: nts

1.March.2008

\*All dimensions are approximate and  
all information is of general nature.

precision**MEASUREMENTS**



as built . space plans  
architectural design

602.790.6412