


# Airport Plaza

939 South 48th Street . Tempe  
Suite 216 - 2,400 RSF

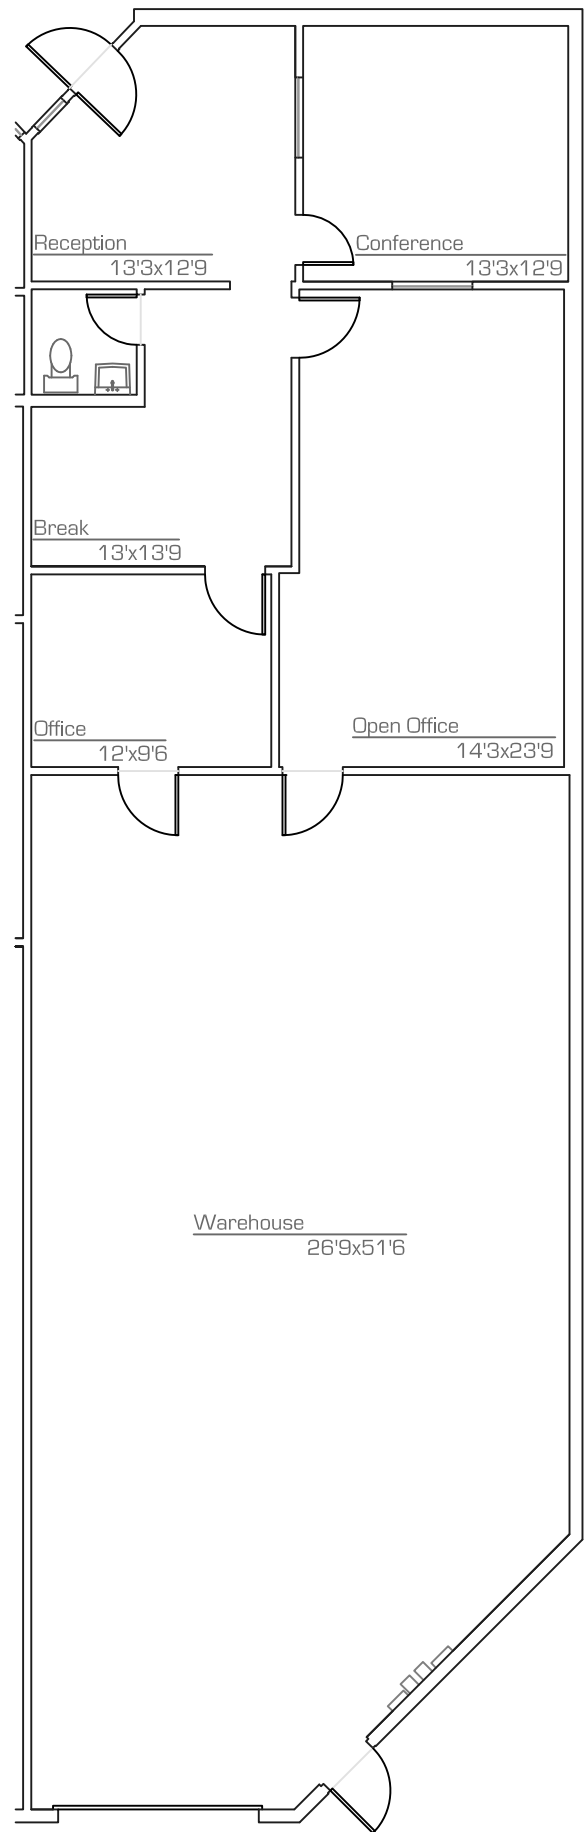

**as-built**

scale: nts  
23.April.2009

\*All dimensions are approximate  
\*All information is of general nature

precision**DIMENSIONS**



as built . space plans  
architectural design

602.790.6412