


Airport Plaza

943 South 48th Street - Tempe

Suite 104 - 1,380 RSF

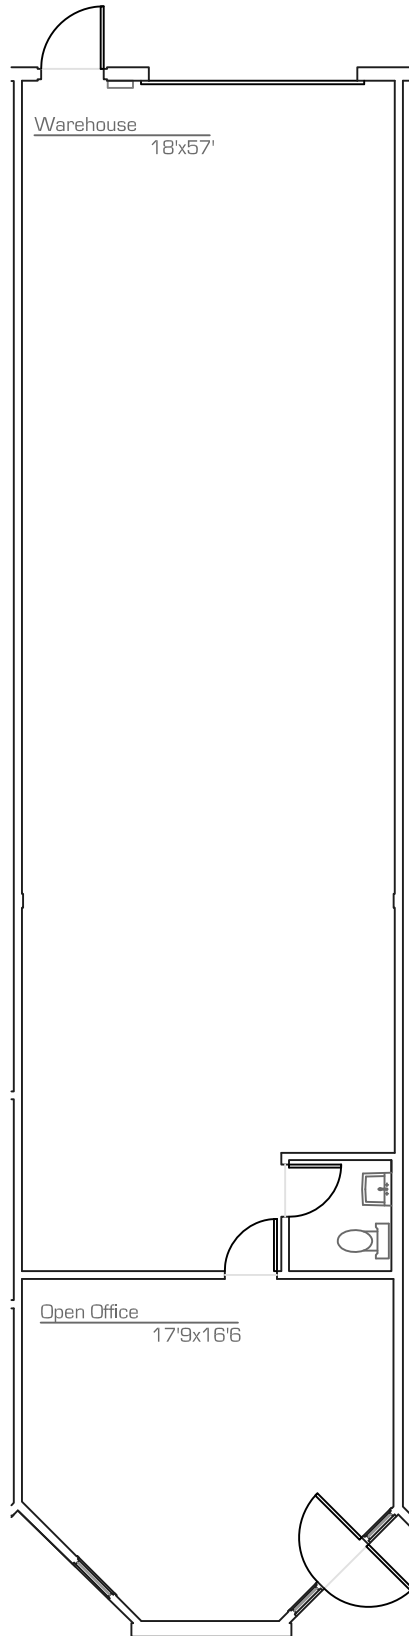

as-built

scale: nts
18.January.2010

*All dimensions are approximate
*All information is of general nature

precision**DIMENSIONS**



as built . space plans
architectural design

602.790.6412