


Airport Plaza

943 South 48th Street - Tempe

Suite 114 - 2,253 RSF

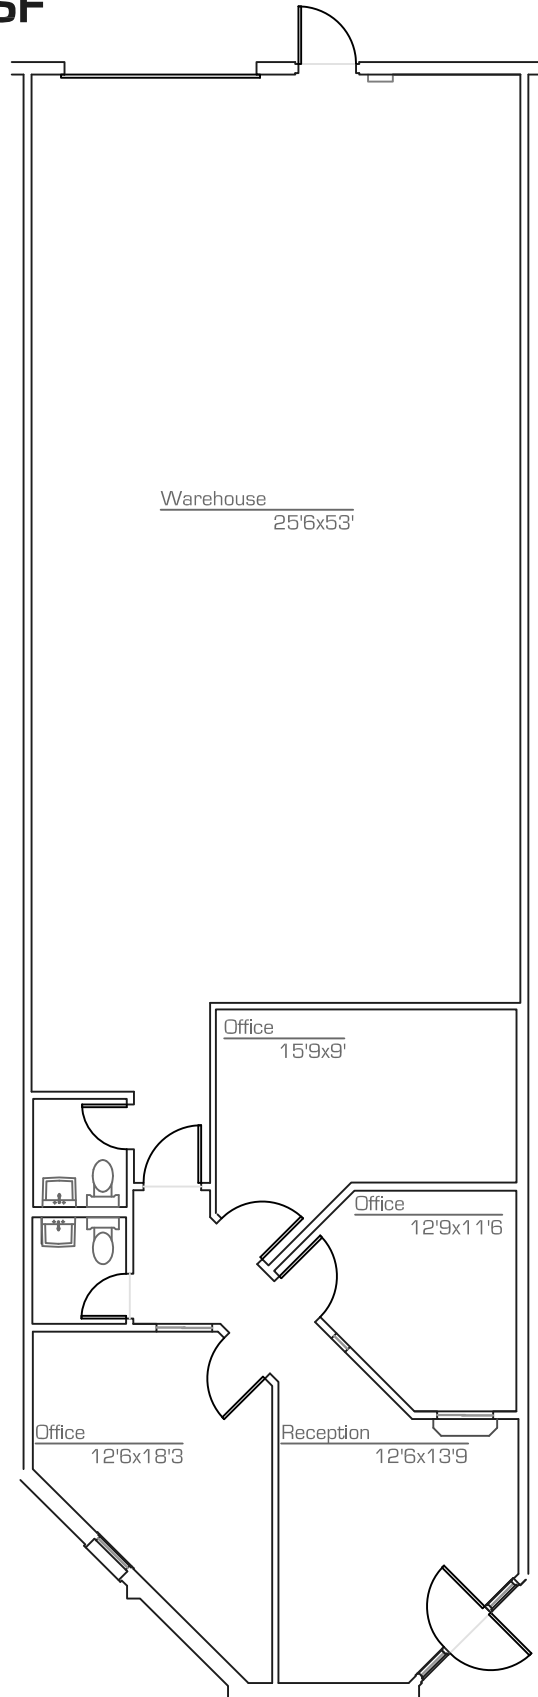


as-built

scale: nts
25.September.2009

*All dimensions are approximate
*All information is of general nature

precision**DIMENSIONS**

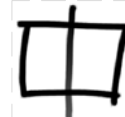

as built . space plans
architectural design

602.790.6412