


Airport Plaza

943 South 48th Street - Tempe

Suite 122/124 - 5,104 RSF

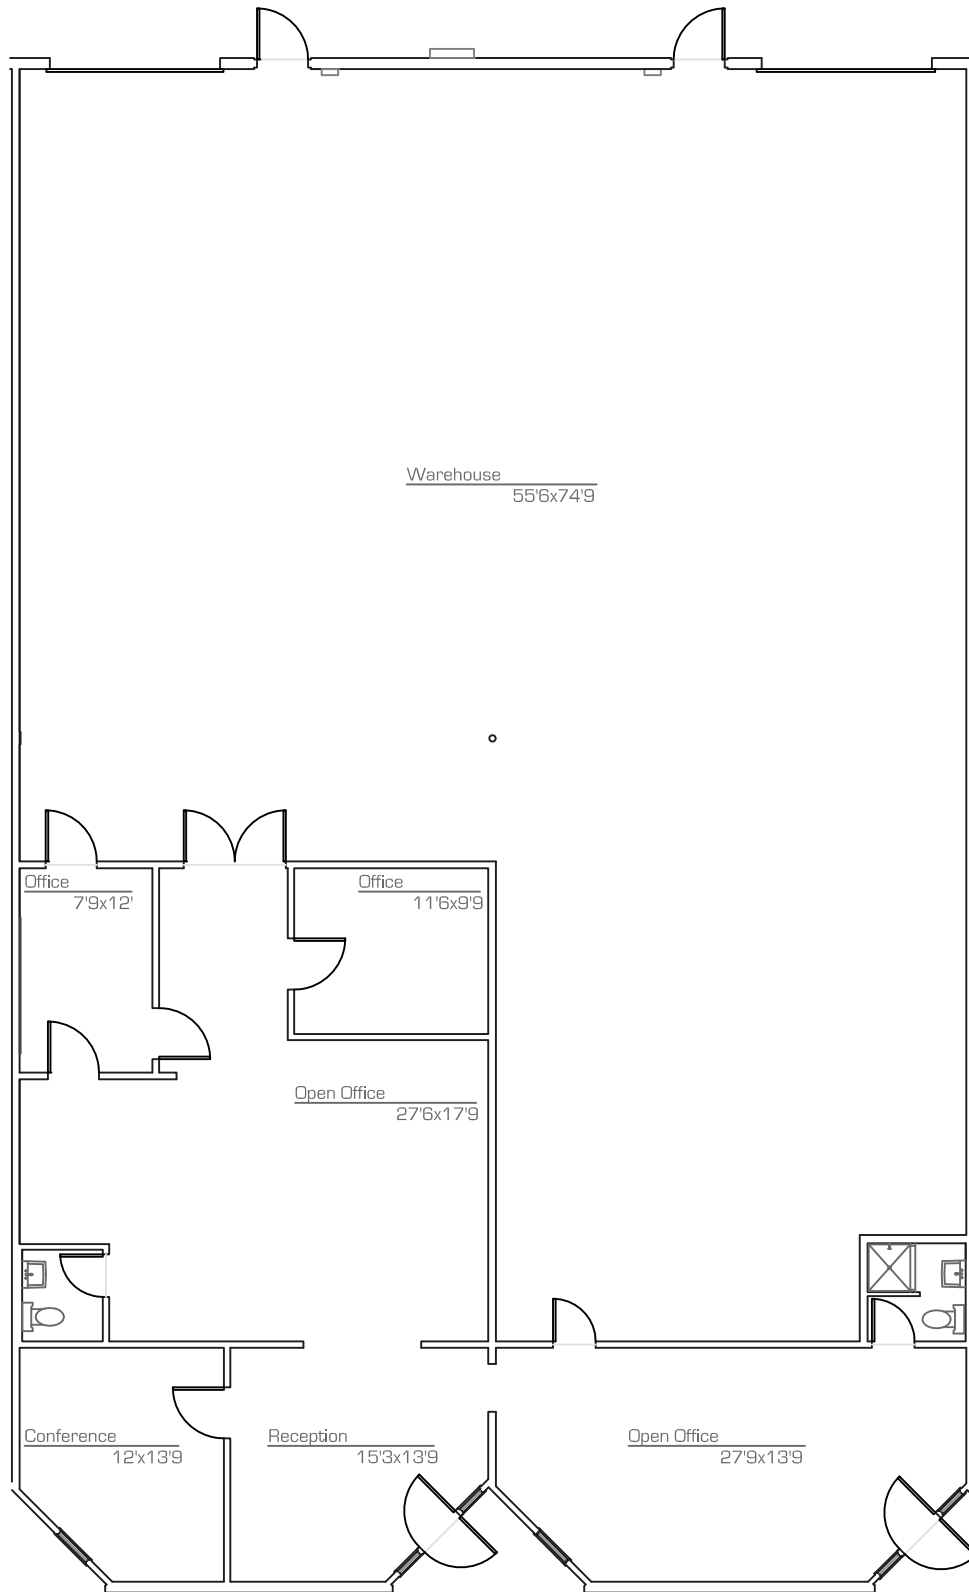

as-built

scale: nts
13.January.2010

*All dimensions are approximate
*All information is of general nature

precision**DIMENSIONS**



as built . space plans
architectural design

602.790.6412