


Airport Plaza

947 South 48th Street - Tempe
Suite 101 - 1,682 RSF

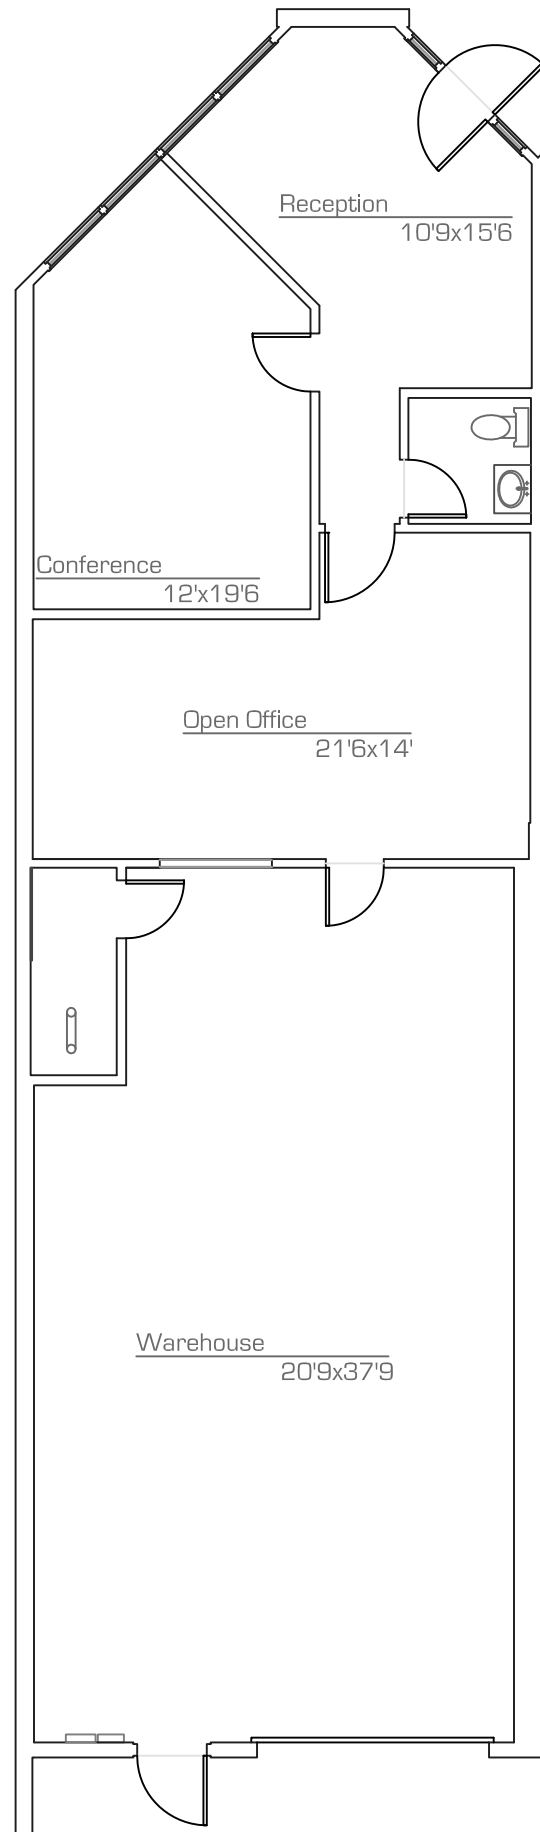


as-built

scale: nts
18.January.2010

*All dimensions are approximate
*All information is of general nature

precision**DIMENSIONS**

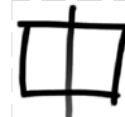

as built . space plans
architectural design

602.790.6412