


Airport Plaza

947 South 48th Street - Tempe

Suite 119 - 2,253 SF

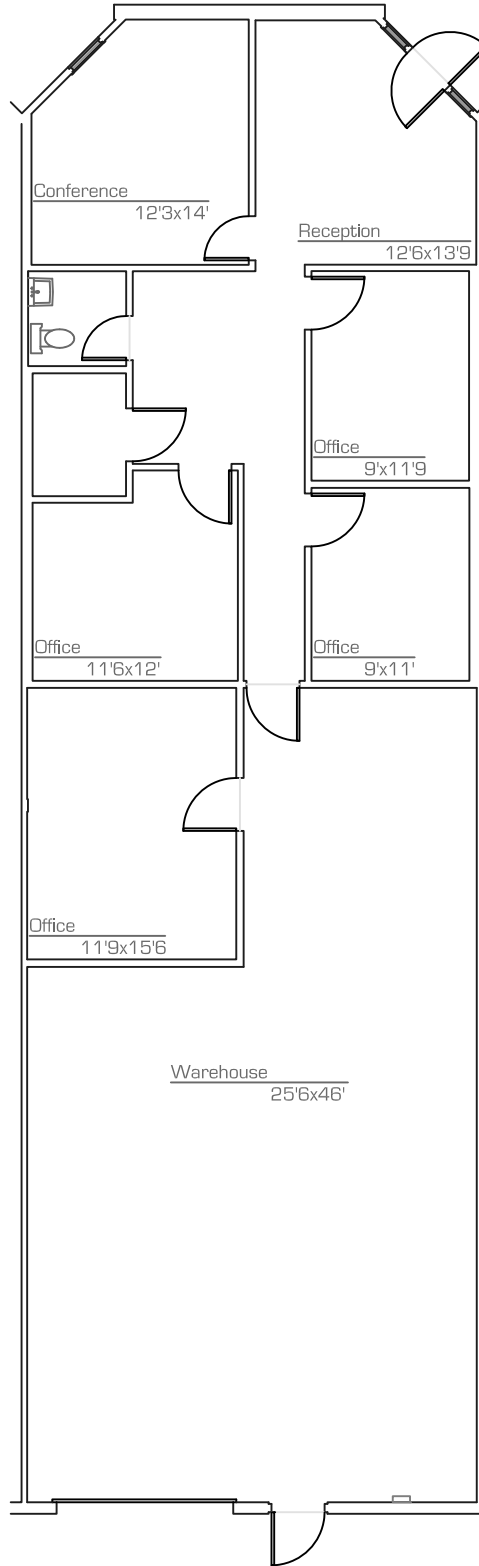

as-built

scale: nts
15.January.2010

*All dimensions are approximate
*All information is of general nature

precision**DIMENSIONS**



as built . space plans
architectural design

602.790.6412