


Airport Plaza

947 South 48th Street - Tempe

Suite 121 - 2,585 SF

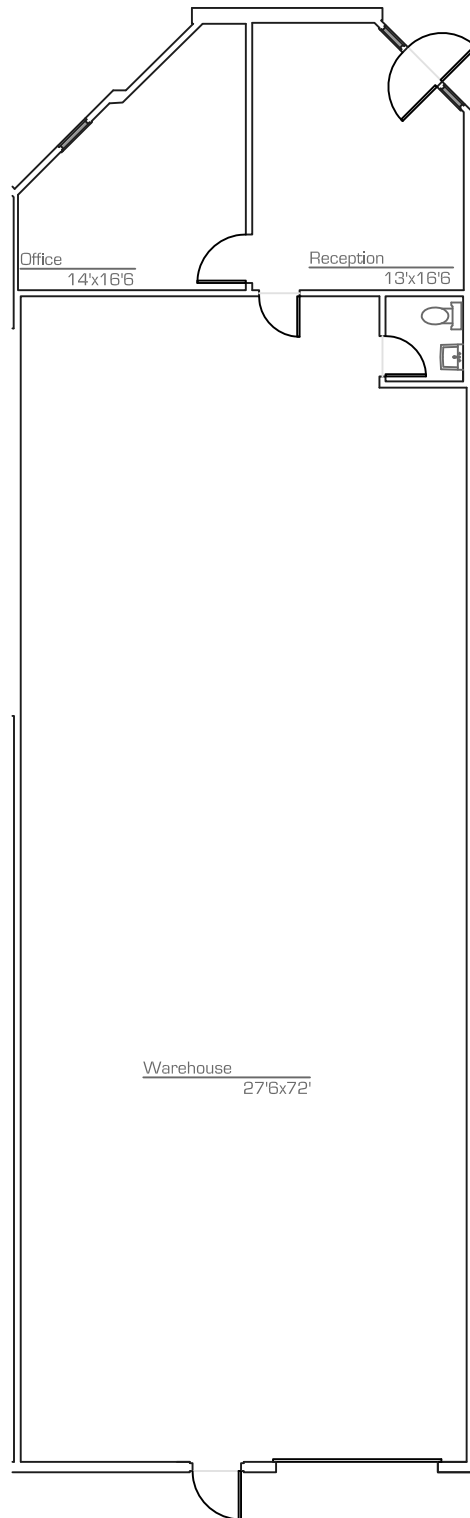

as-built


scale: nts

15.January.2010

*All dimensions are approximate

*All information is of general nature

precision**DIMENSIONS**

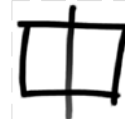

as built . space plans
architectural design

602.790.6412