


# Airport Plaza

947 South 48th Street - Tempe  
Suite 123/125 - 5,170 SF

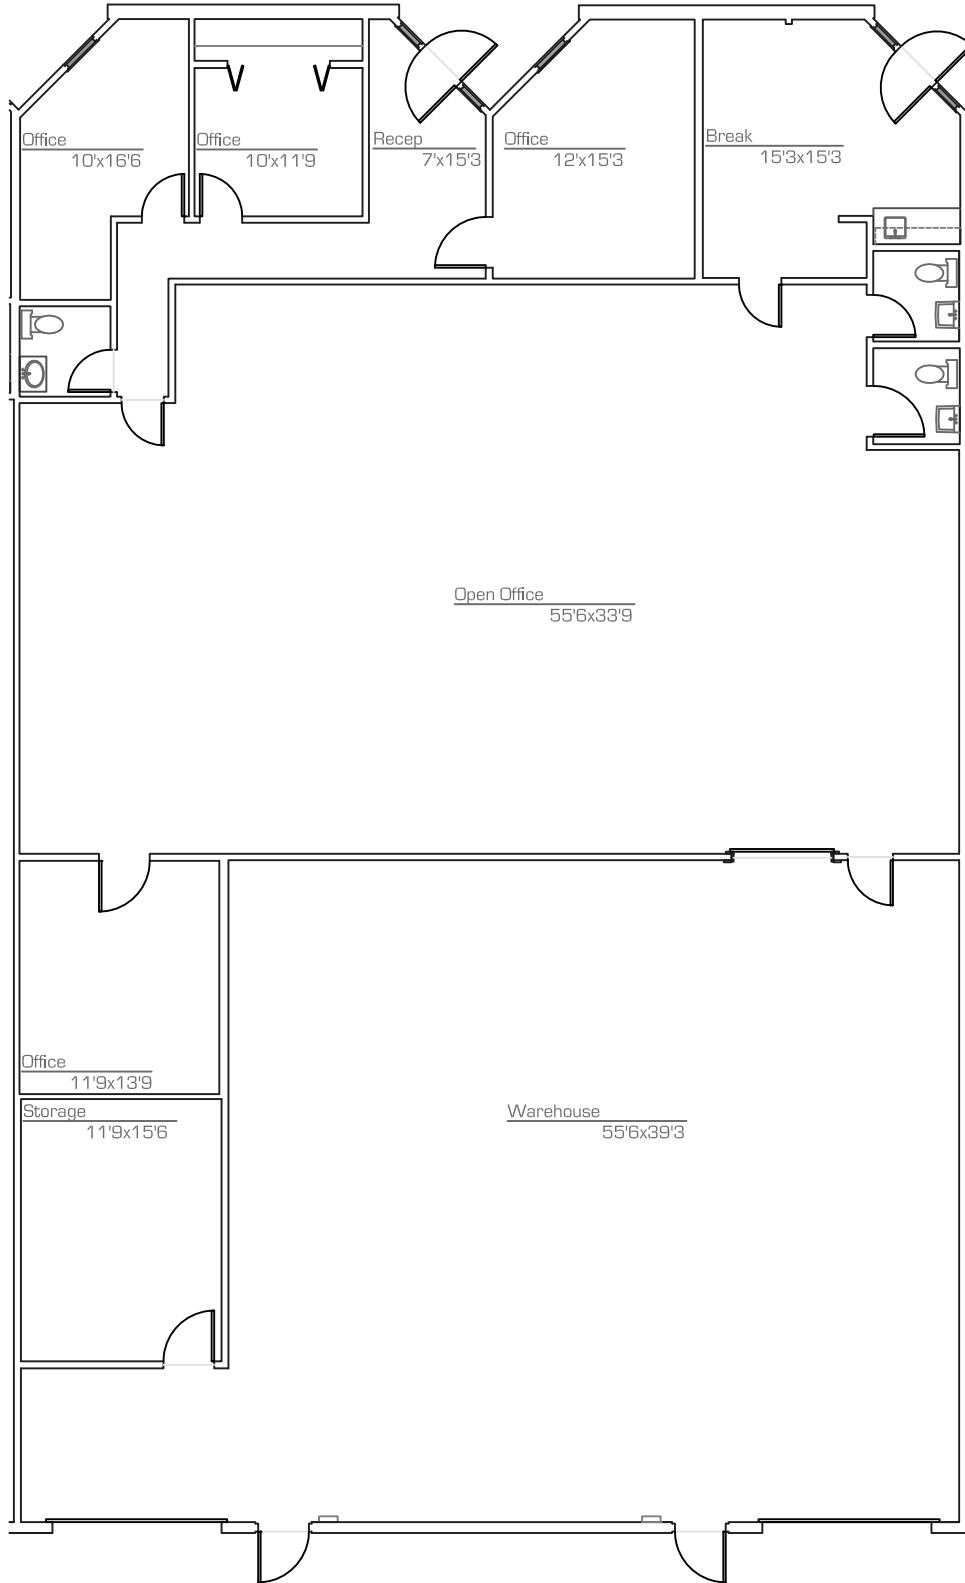

**as-built**

scale: nts  
15.January.2010

\*All dimensions are approximate  
\*All information is of general nature

precision**DIMENSIONS**



as built . space plans  
architectural design

602.790.6412