
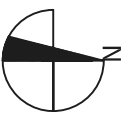


# Desert Vista Commerce Center

7890 South Hardy Drive

Suite 100 - 10,817 RSF

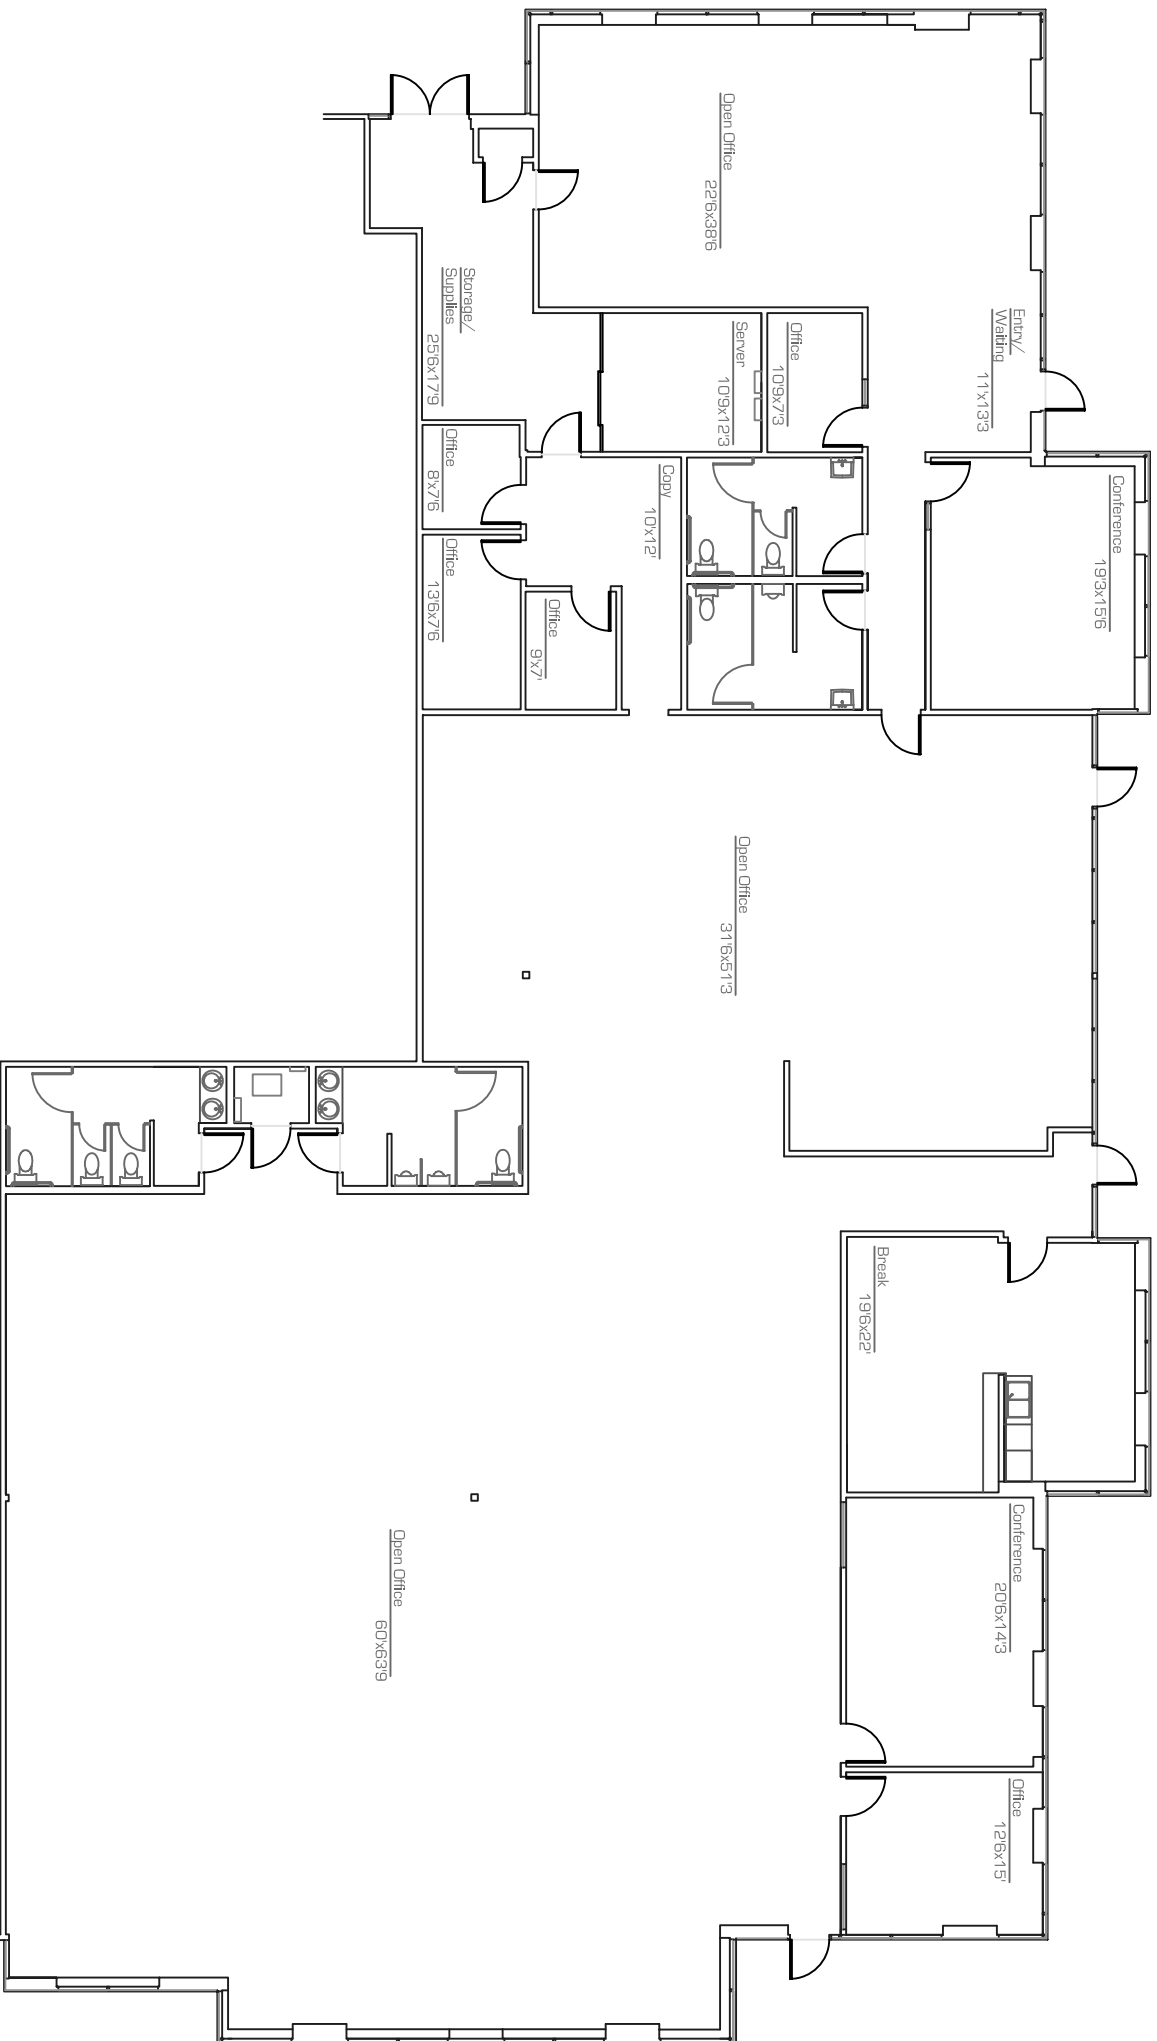

**as-built**

scale: nts

3.November.2008

\* All dimensions are approximate

\* All information is of general nature

**precision DIMENSIONS**

as built . space plans  
architectural design

602.790.6412

