


Desert Vista Commerce Center

7810 South Hardy Drive . Tempe

Suite 108 - 5,700 RSF

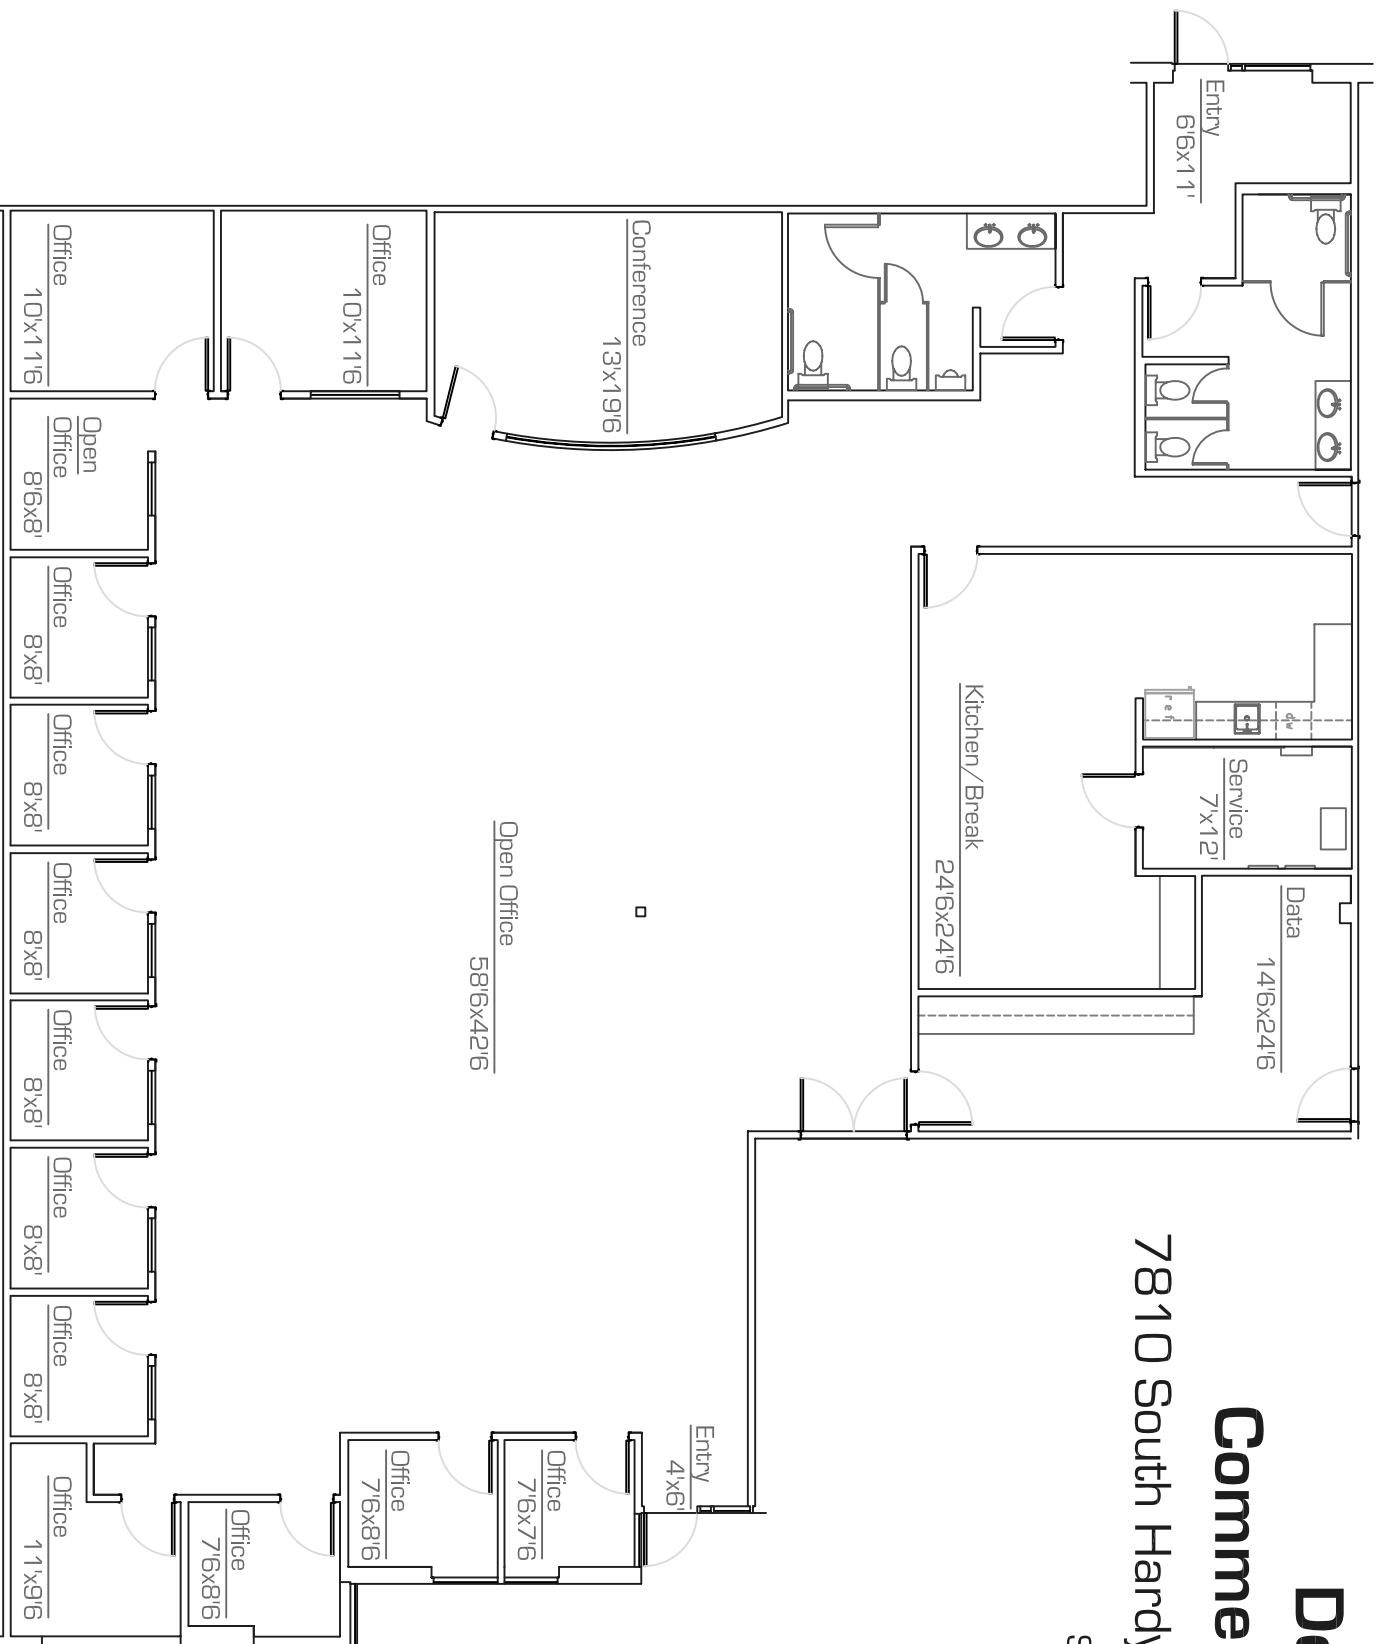

as-built

scale: nts

29.nov.2006

* All dimensions are approximate and all information is of general nature.

precisionMEASUREMENTS



as-built . space plans
architectural design

602.790.6412