


Desert Vista Commerce Center

7810 South Hardy Dr
Suite 113 - 8,580 RSF

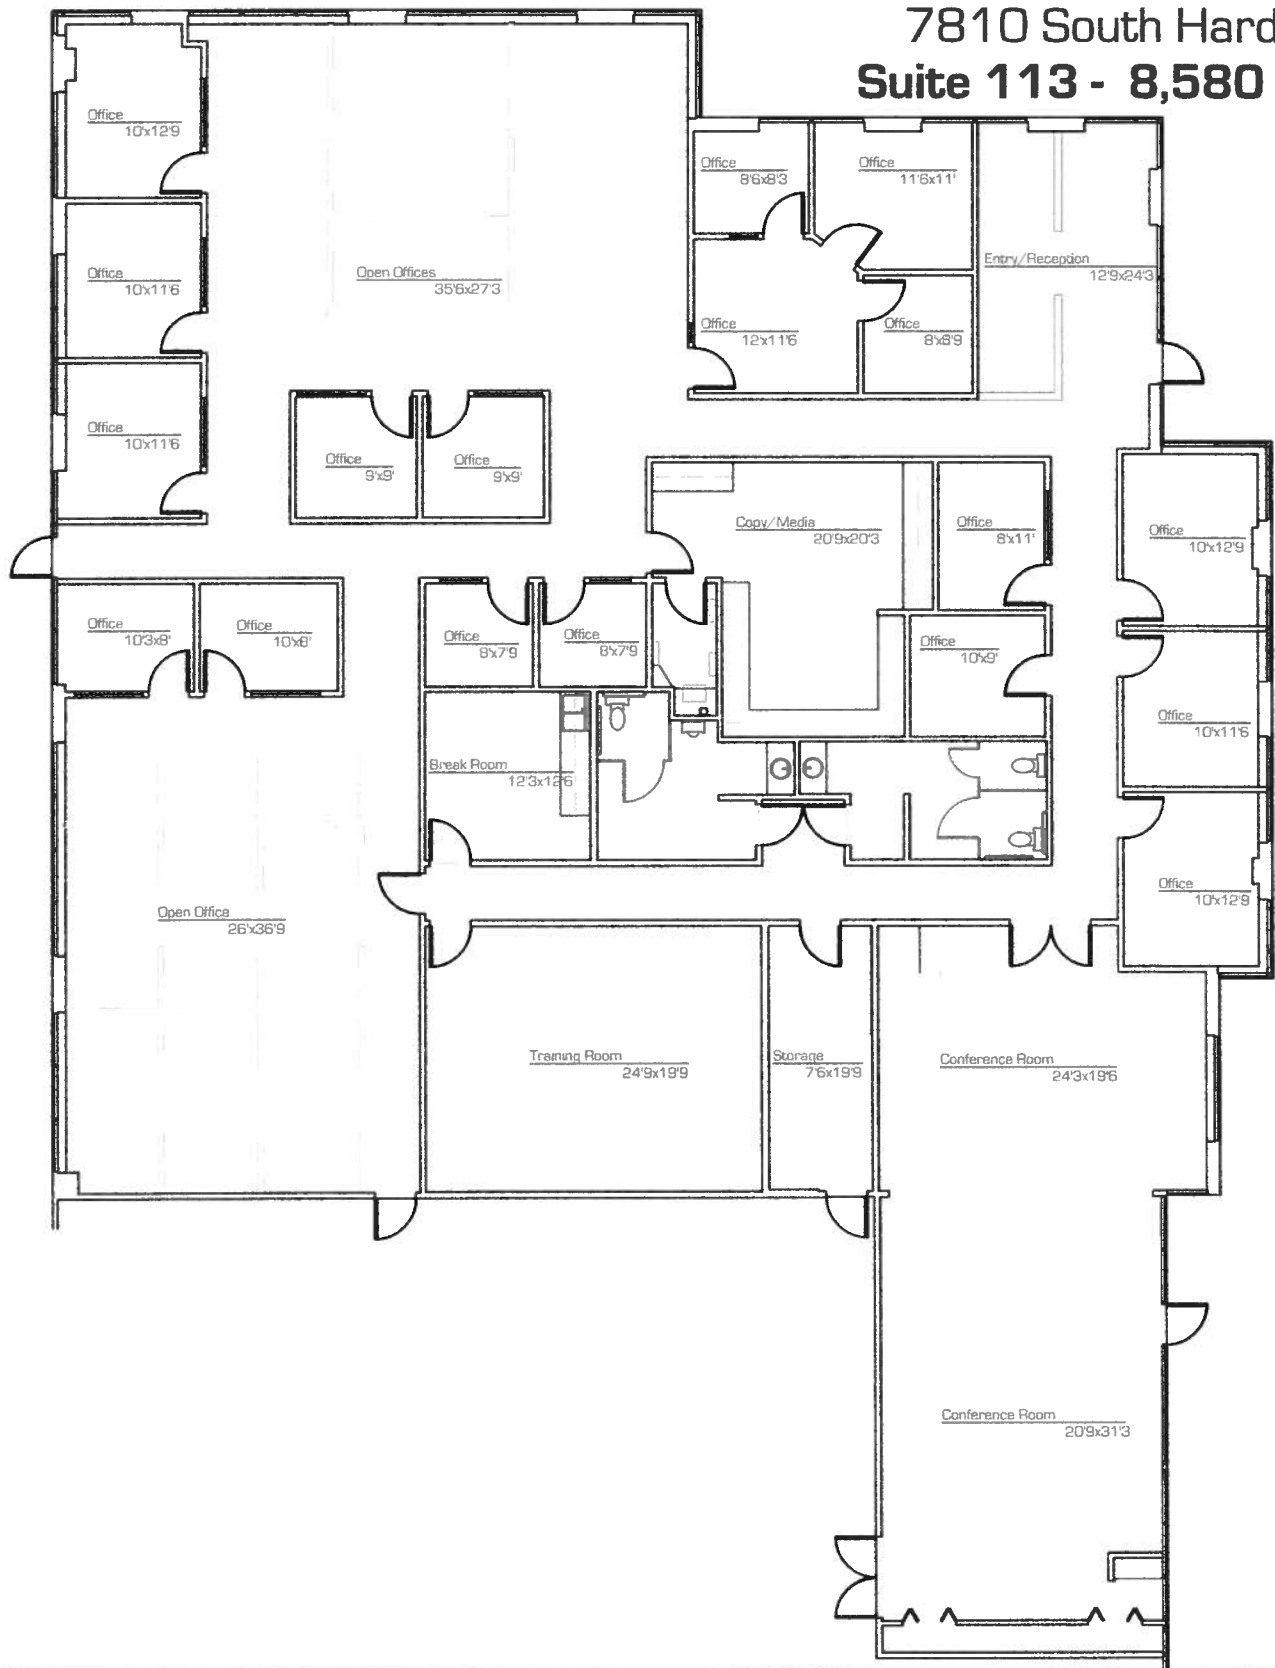

as-built

scale: nts
1.April.2008

*All dimensions are approximate
*All information is of general nature

precision**MEASUREMENTS**



as built . space plans
architectural design

602.790.6412