


1950 West Rose Garden Lane

Suite 110 - 9,349 SF

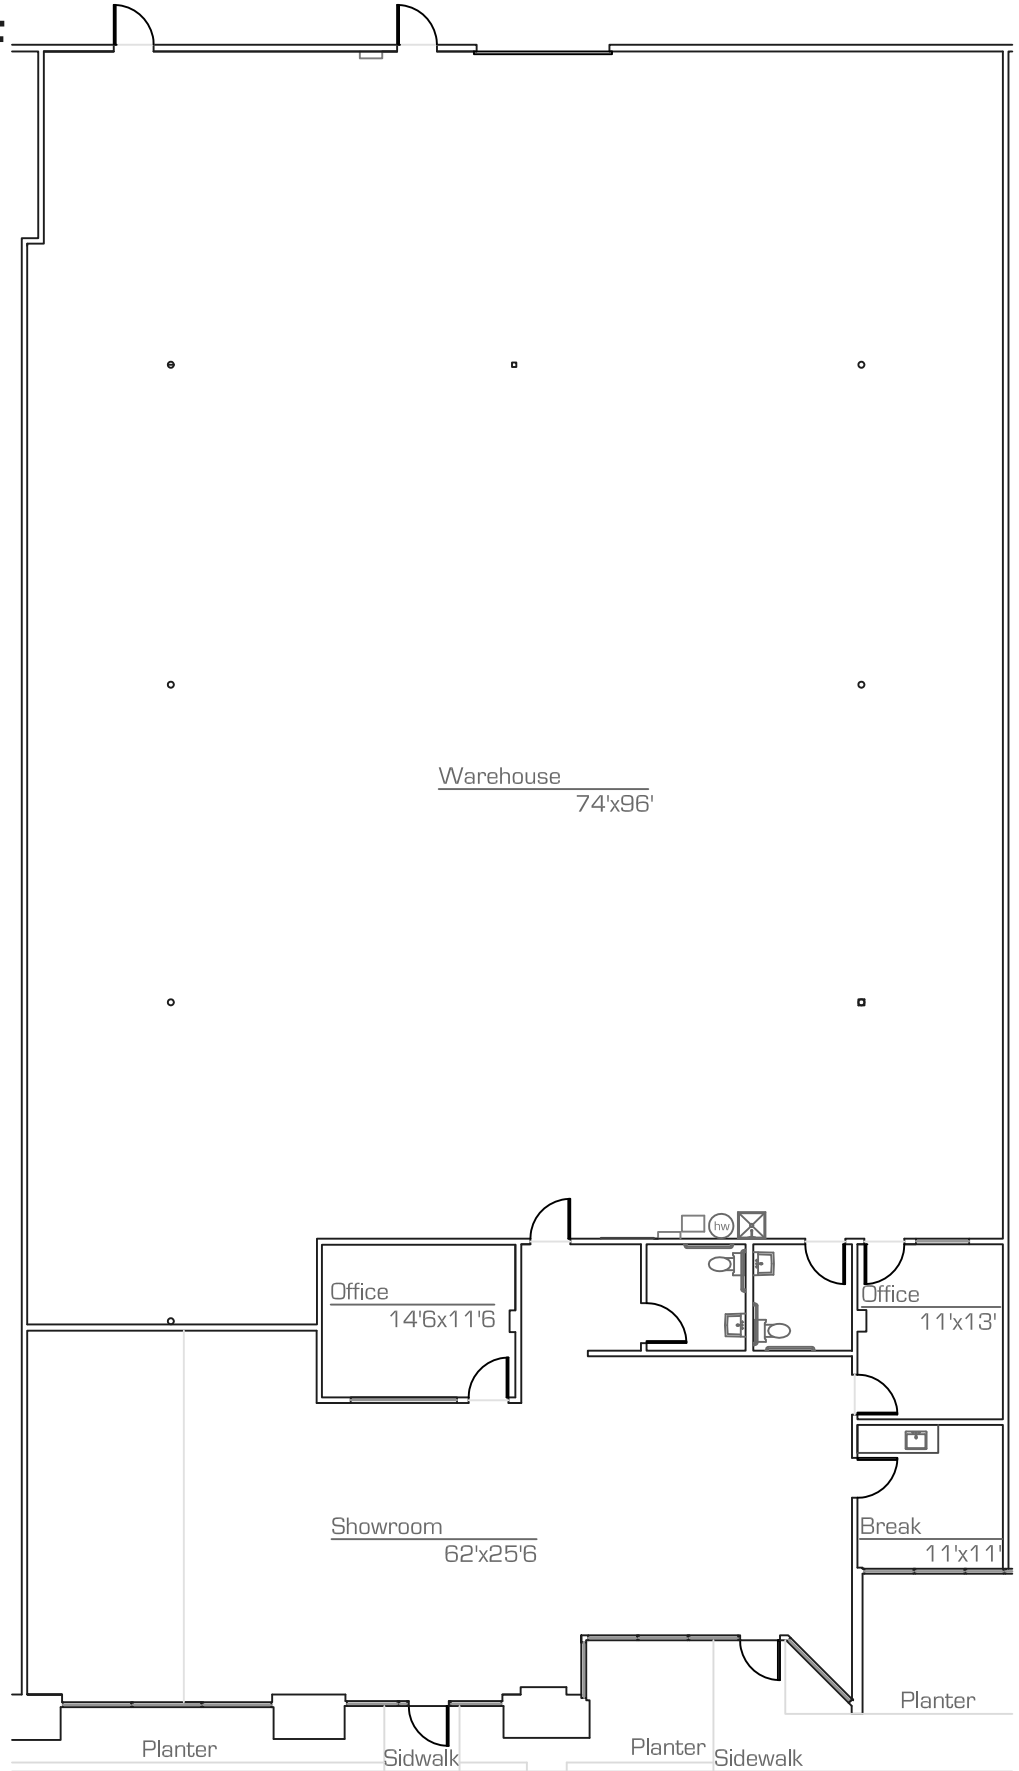

as-built

scale: nts
14.July.2009

*All dimensions are approximate
*All information is of general nature

precision**DIMENSIONS**



as built . space plans
architectural design

602.790.6412