


1950 West Rose Garden Lane

Suite 140 - 6,423 SF

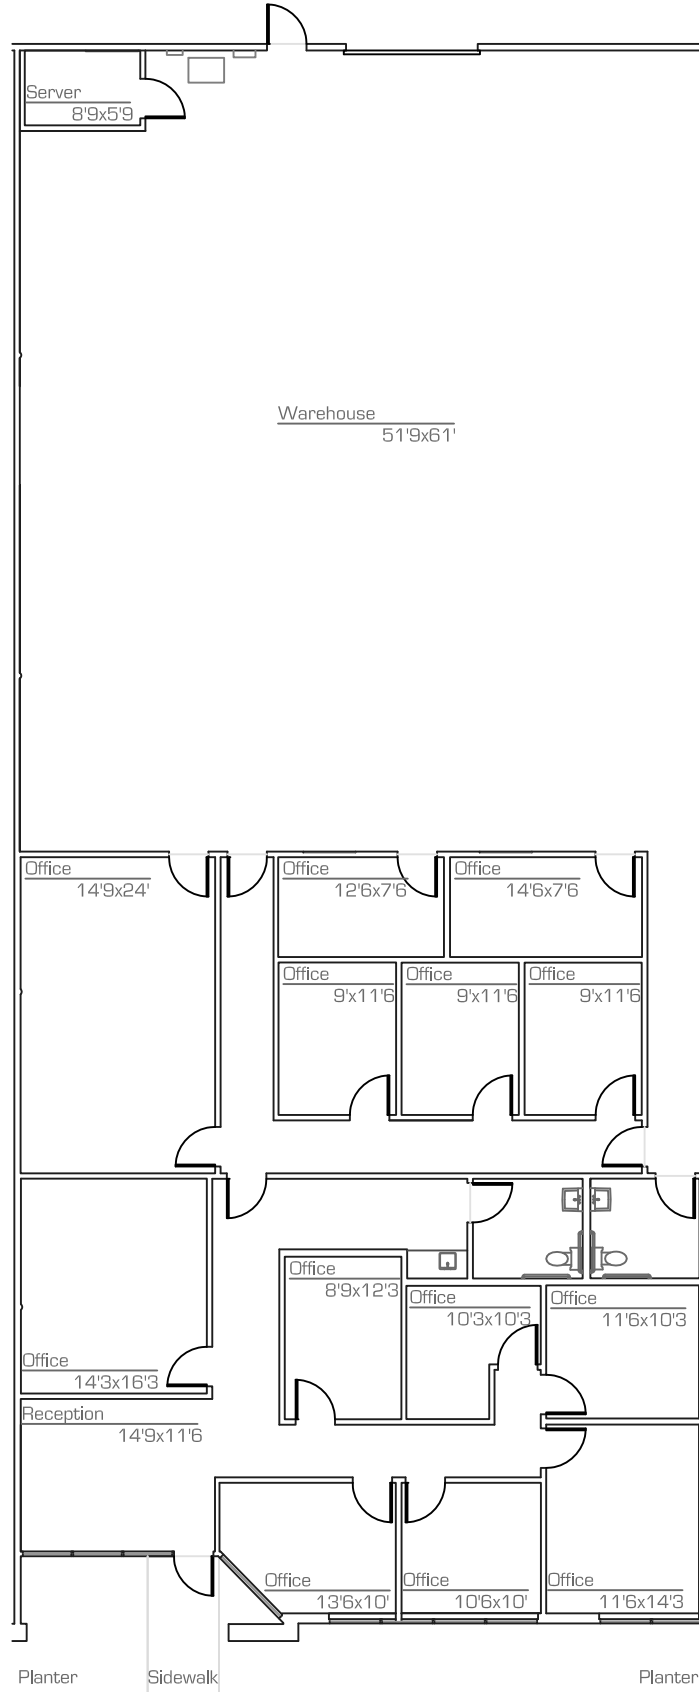

as-built

scale: nts
6.May.2009

*All dimensions are approximate
*All information is of general nature

precision**DIMENSIONS**



as built . space plans
architectural design

602.790.6412