


Green Gables

2345 East Thomas Road . Phoenix . Arizona

Suite 280 - 439 RSF

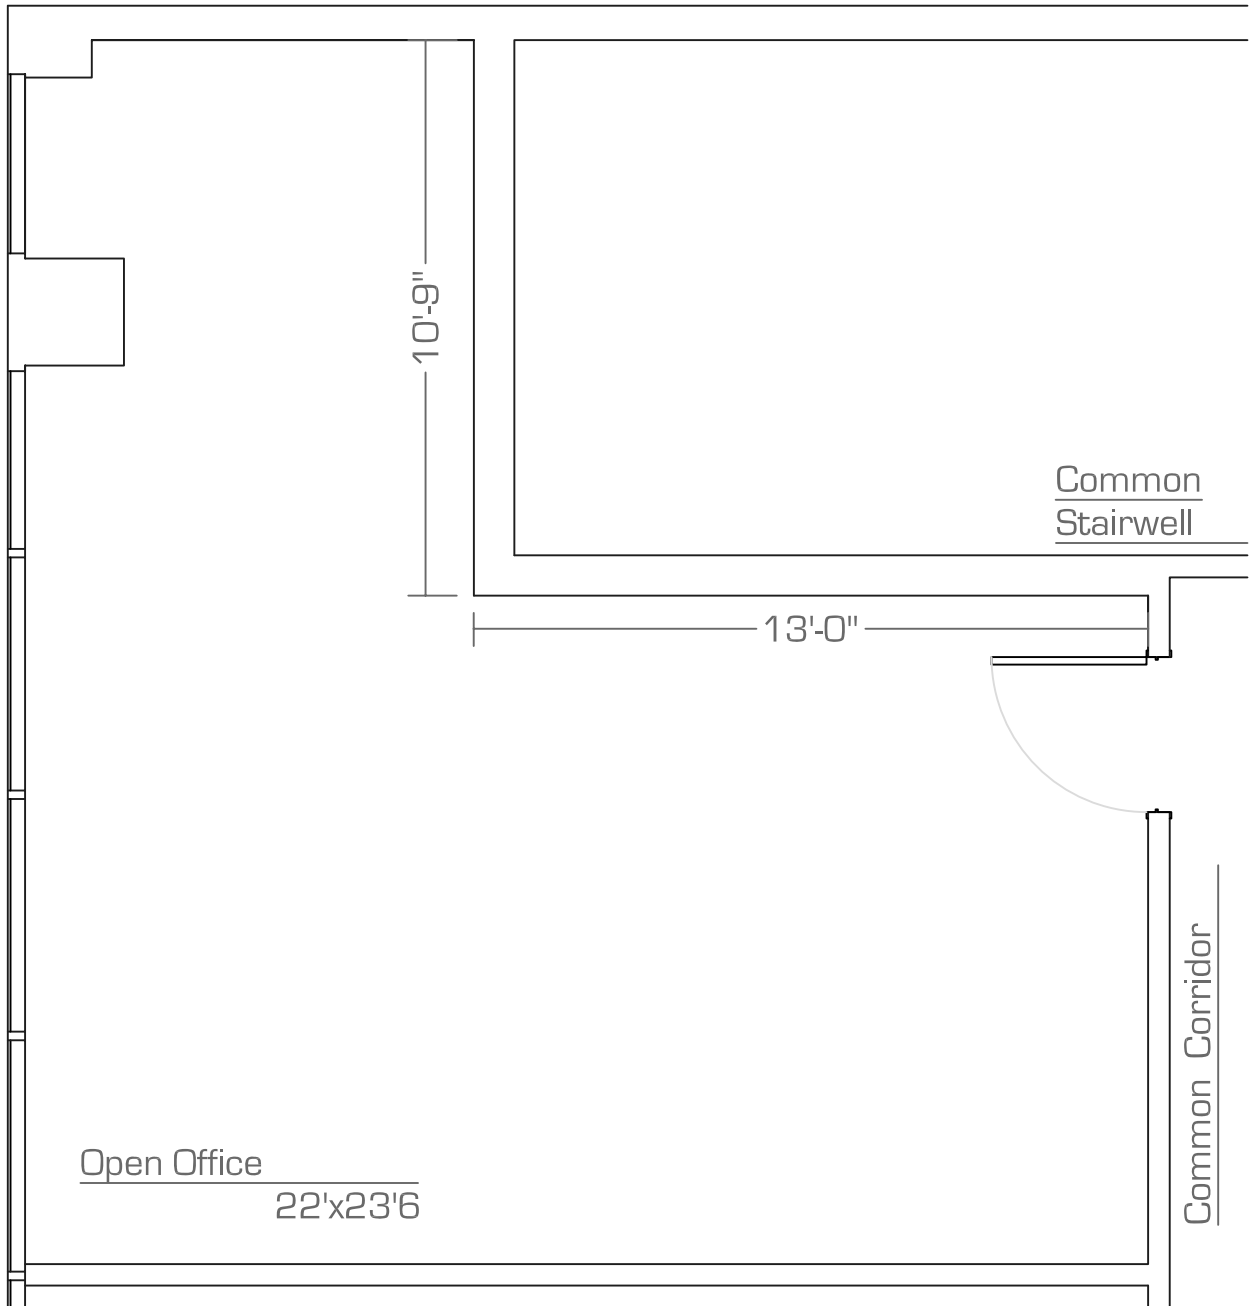

as-built

scale: nts

23.July.2007

*All dimensions are approximate and all information is of general nature.

precision**MEASUREMENTS**



as-built . space plans
architectural design

602.790.6412