


Green Gables

2345 East Thomas Road . Phoenix . Arizona
Suite 102 - 1,034 RSF

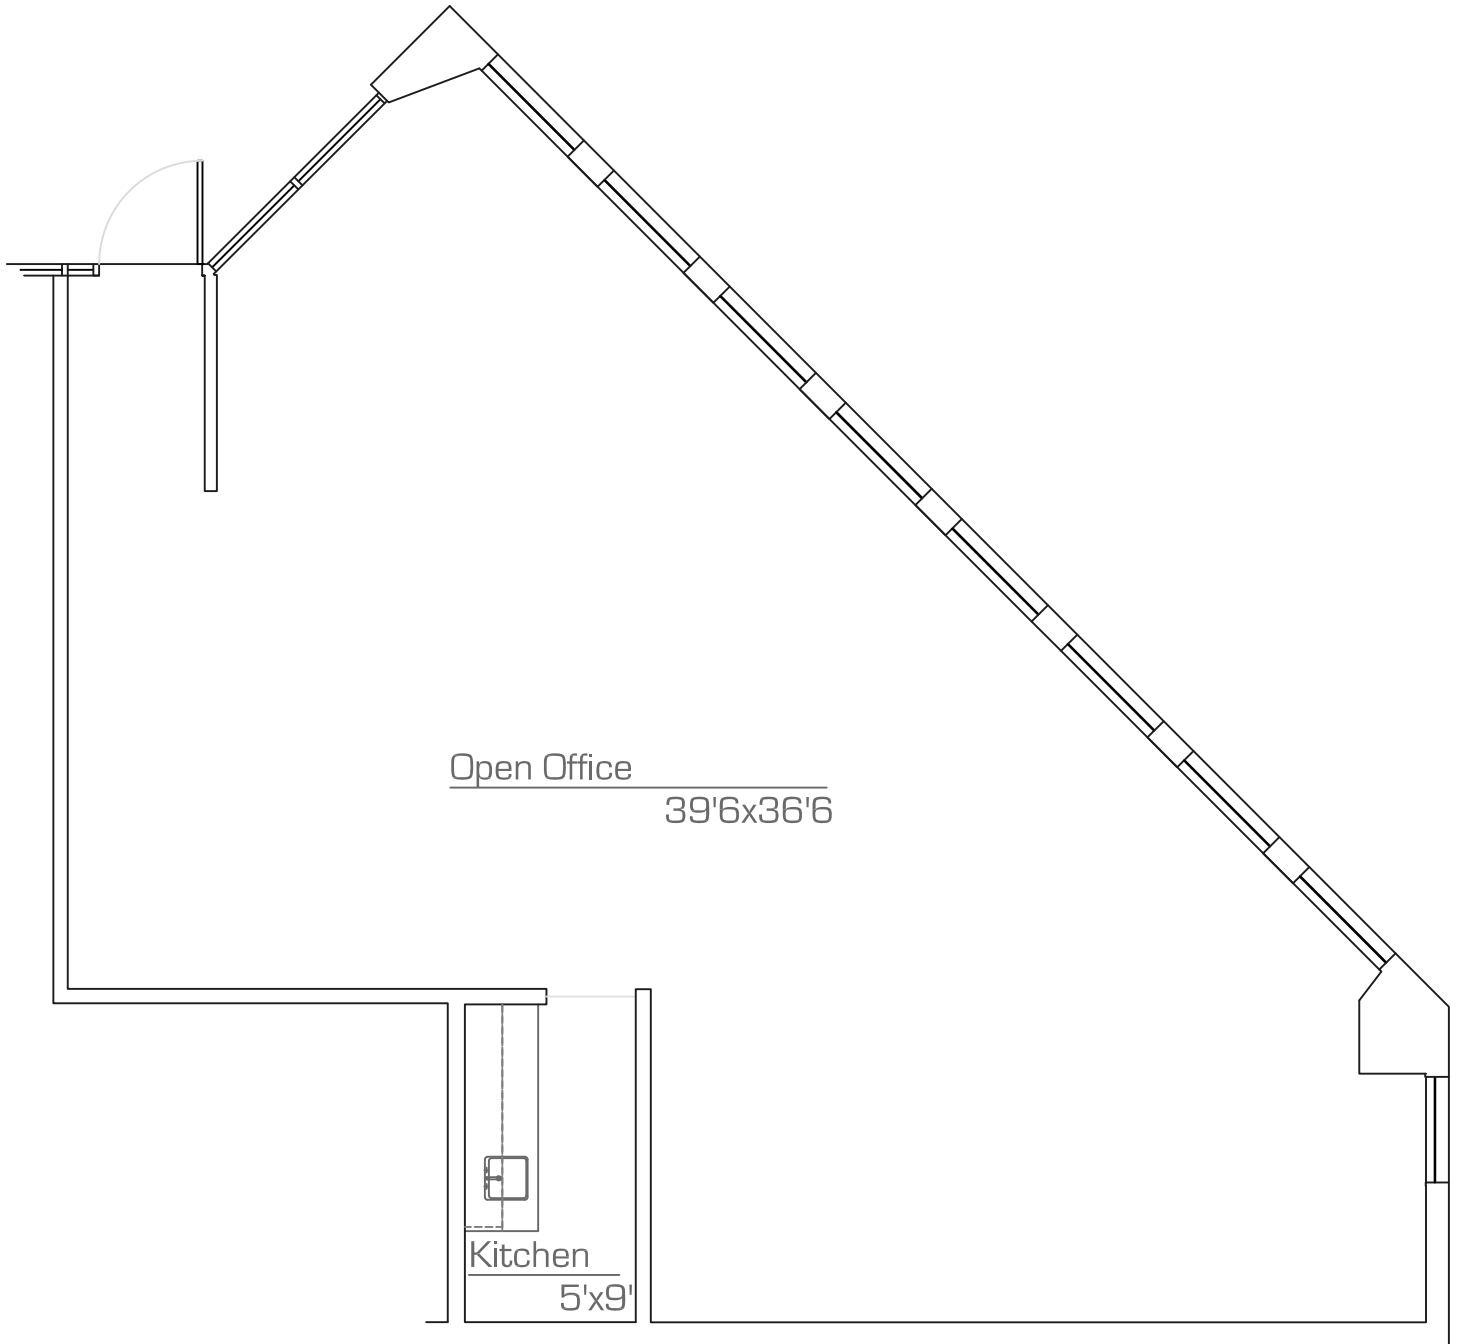

as-built

scale: nts

17.March.2009

*All dimensions are approximate and all information is of general nature.

precision**DIMENSIONS**



as-built . space plans
architectural design

602.790.6412