


Green Gables

2345 East Thomas Road . Phoenix

Suite 150 - 1,628 RSF

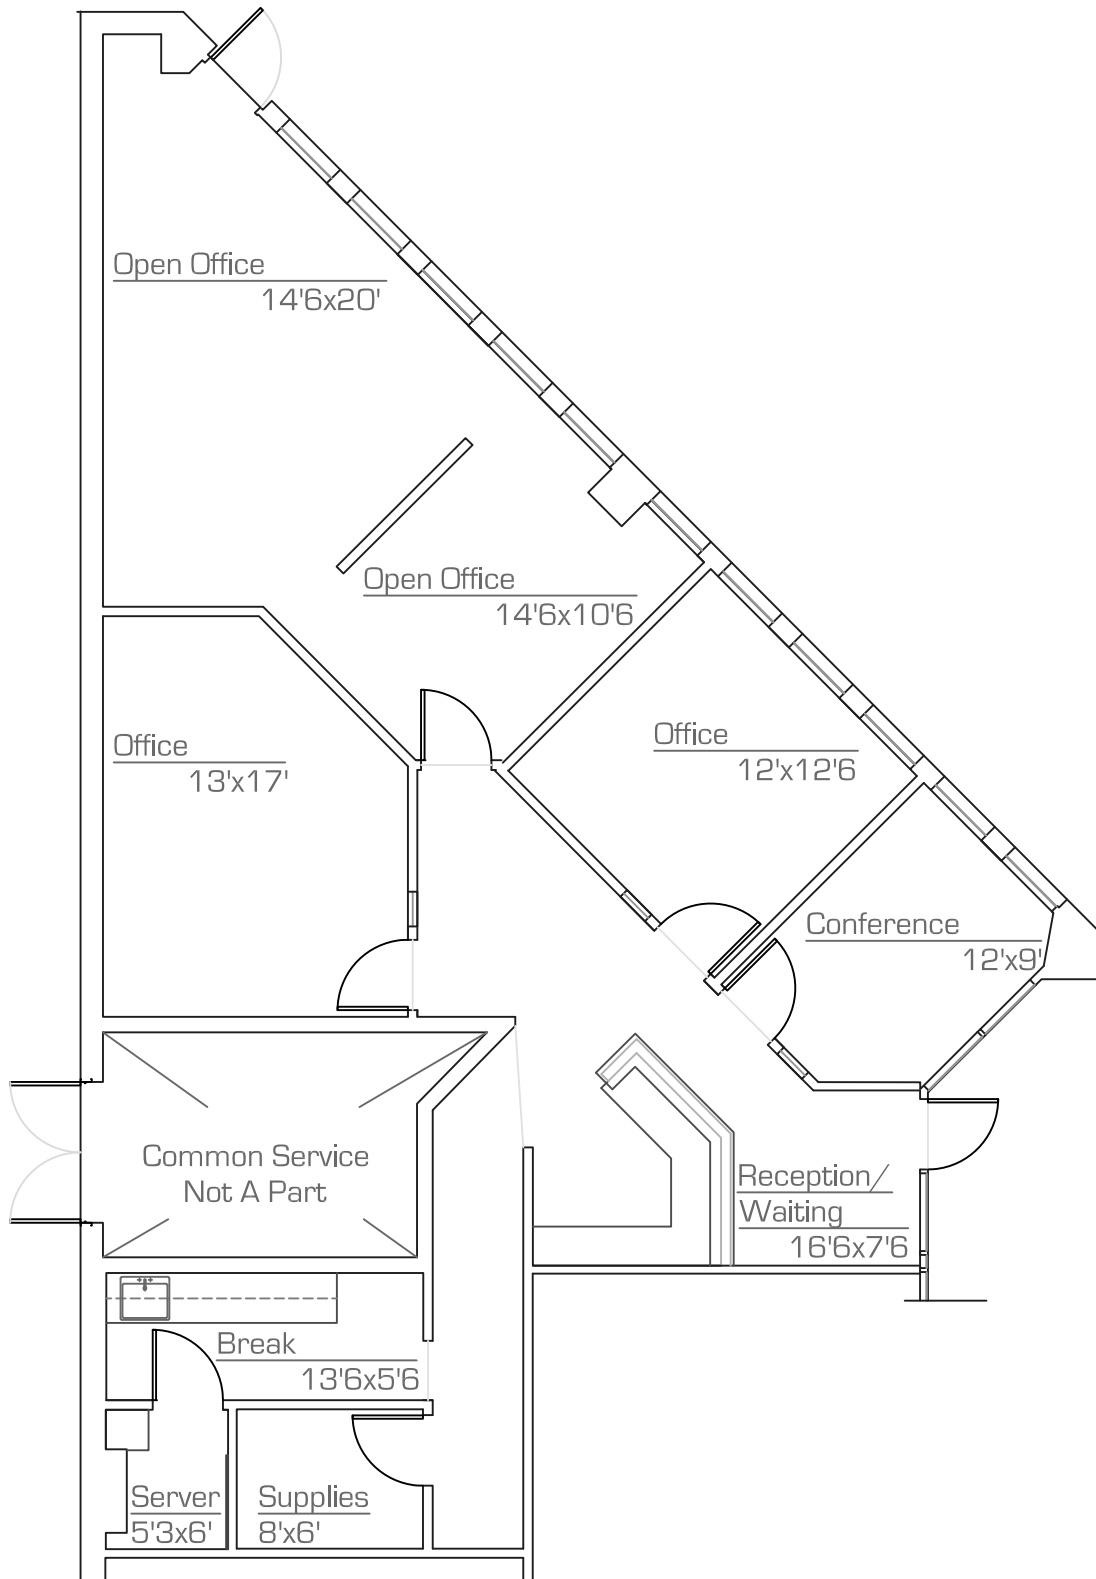

as-built

scale: nts
7.January.2012



*All dimensions are approximate at $\pm 3"$
*All information is of general nature

precision**DIMENSIONS**



as built . space plans
architectural design

602.790.6412

