


Green Gables

2345 East Thomas Road

Suite 200A - 800 RSF

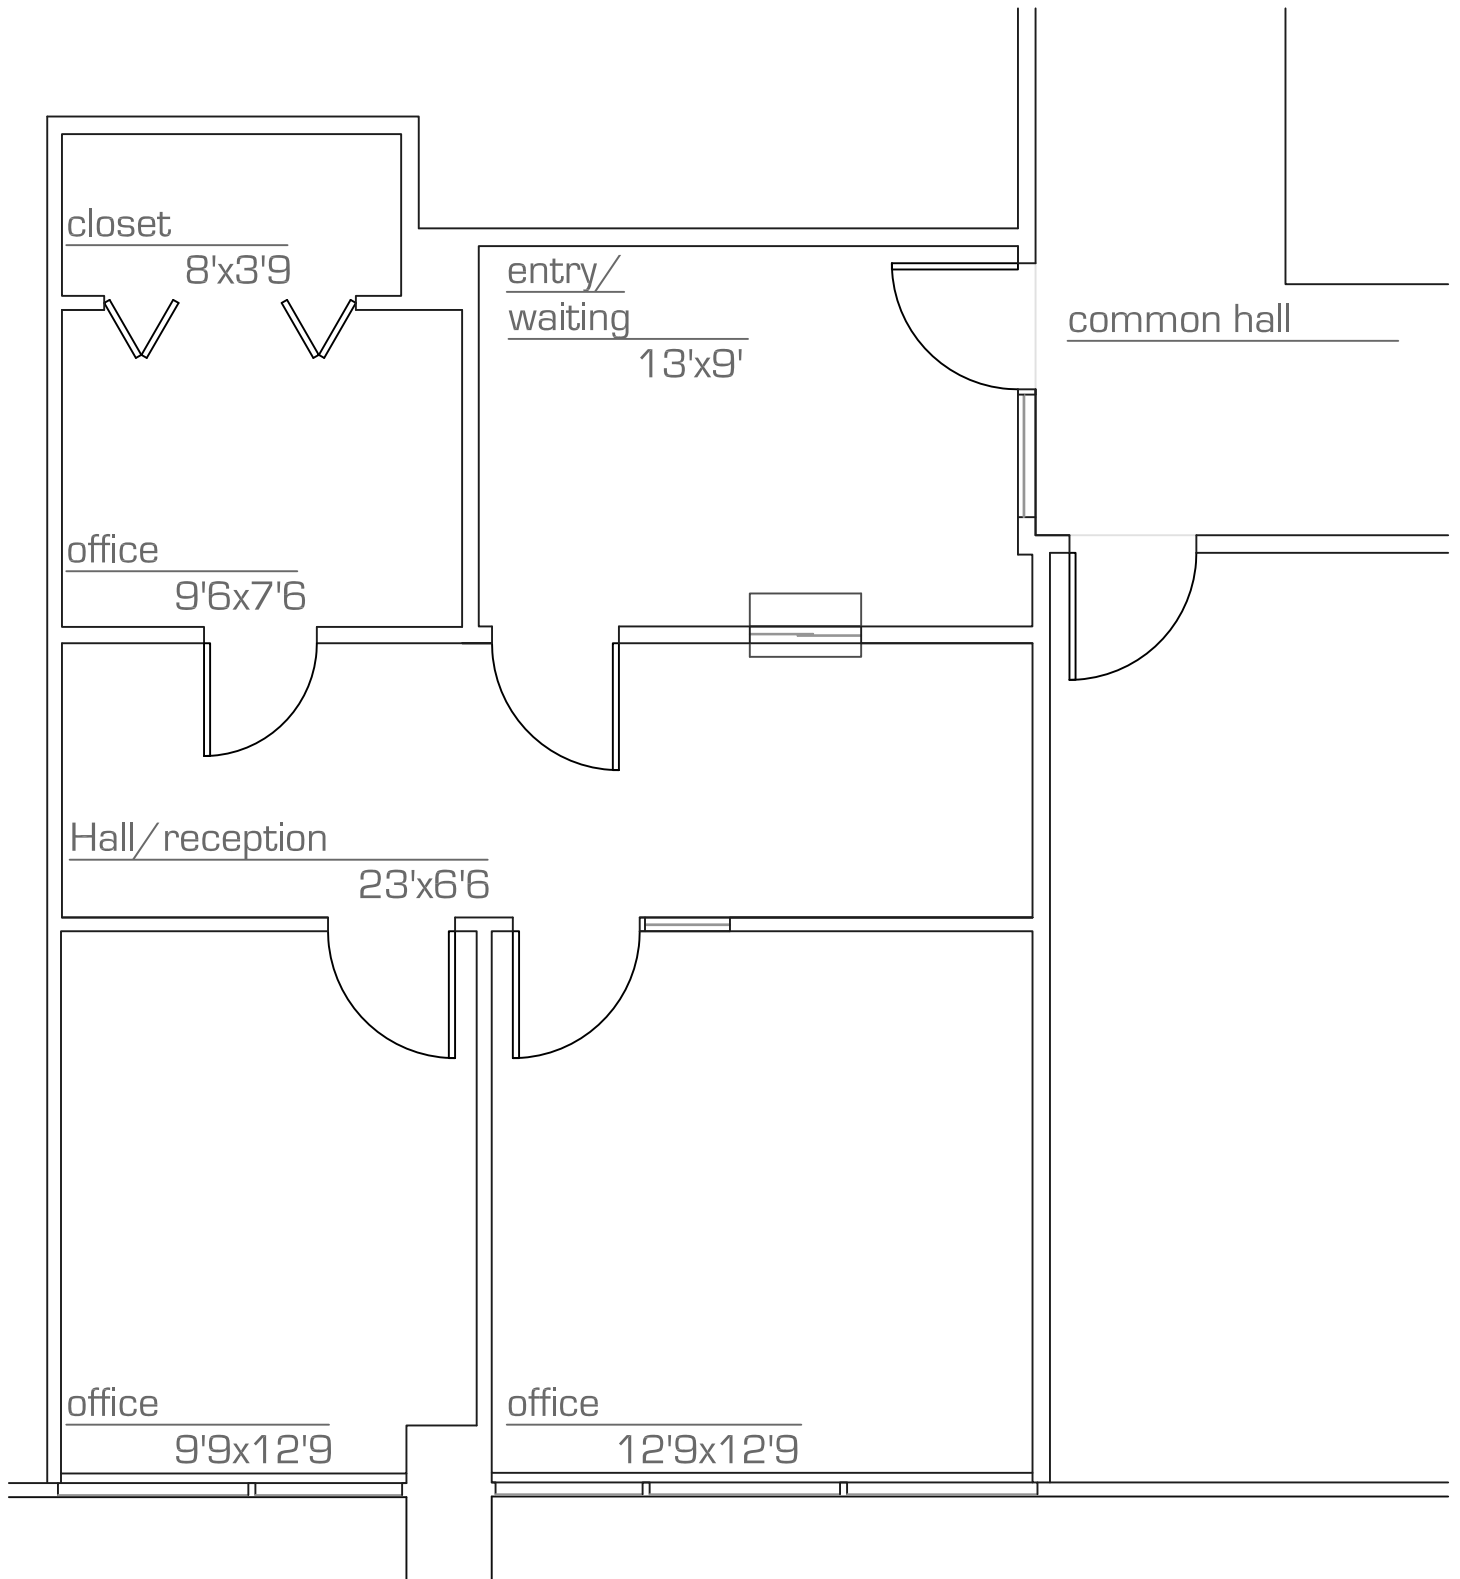


as-built

scale: nts

13.March.2008

*All dimensions are approximate and all information is of general nature.

precision**DIMENSIONS**

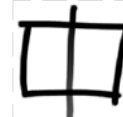

as-built . space plans
architectural design

602.790.6412